

1920 Brass Cap,
0.8' High, E-W
Fence
Lat: 40.944097°
Long: 104.485356°

T11N, R63W, 6th P.M.

EOG RESOURCES, INC.

Well location, (AS-BUILT) CRITTER CREEK
#11-07H, located as shown in the SE 1/4 SE
1/4 of Section 7, T11N, R63W, 6th P.M., Weld
County, Colorado.


BASIS OF ELEVATION

SPOT ELEVATION AT THE NORTHEAST CORNER OF SECTION
1, T11N, R63W, 6th P.M. TAKEN FROM THE HEREFORD,
QUADRANGLE, COLORADO, WELD COUNTY, 7.5 MINUTE QUAD
(TOPOGRAPHIC MAP) PUBLISHED BY THE UNITED STATES
DEPARTMENT OF THE INTERIOR, GEOLOGICAL SURVEY. SAID
ELEVATION IS MARKED AS BEING 5352 FEET.

BASIS OF BEARINGS

BASIS OF BEARINGS IS A G.P.S. OBSERVATION.

LINE TABLE		
LINE	BEARING	LENGTH
L1	N44°59'01"W	706.11'
L2	N34°12'44"W	296.79'

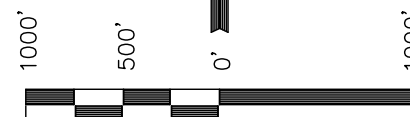

SCALE

CERTIFICATE

THIS IS TO CERTIFY THAT THE ABOVE PLAT WAS PREPARED FROM
FIELD NOTES OF ACTUAL SURVEYS MADE BY ME OR UNDER MY
SUPERVISION AND THAT THE SAME ARE TRUE AND CORRECT TO THE
BEST OF MY KNOWLEDGE AND BELIEF.

REGISTERED LAND SURVEYOR
REGISTRATION NO. 17492
STATE OF COLORADO
03-13-11

R
64
W

R
63
W

NAD 83 (BOTTOM HOLE)	NAD 83 (TOP OF PRODUCING INTERVAL)	NAD 83 (SURFACE LOCATION)
LATITUDE = 40°56'32.77" (40.942436)	LATITUDE = 40°56'35.19" (40.943108)	LATITUDE = 40°55'51.44" (40.930956)
LONGITUDE = 104°29'02.16" (104.483933)	LONGITUDE = 104°29'04.34" (104.484539)	LONGITUDE = 104°28'05.45" (104.468181)
NAD 27 (BOTTOM HOLE)	NAD 27 (TOP OF PRODUCING INTERVAL)	NAD 27 (SURFACE LOCATION)
LATITUDE = 40°56'32.83" (40.942453)	LATITUDE = 40°56'35.25" (40.943125)	LATITUDE = 40°55'51.50" (40.930972)
LONGITUDE = 104°29'00.31" (104.483419)	LONGITUDE = 104°29'02.49" (104.484025)	LONGITUDE = 104°28'03.60" (104.467667)
STATE PLANE NAD 83	STATE PLANE NAD 83	STATE PLANE NAD 83
N: 1587791.15 E: 3280714.52	N: 1588034.14 E: 3280544.42	N: 1583658.68 E: 3285115.11
STATE PLANE NAD 27	STATE PLANE NAD 27	STATE PLANE NAD 27
N: 587789.02 E: 2280864.07	N: 588032.01 E: 2280693.97	N: 583656.63 E: 2285264.61

PDOP = 2.1

UINTAH ENGINEERING & LAND SURVEYING
85 SOUTH 200 EAST - VERNAL, UTAH 84078
(435) 789-1017

SCALE 1" = 1000'	DATE SURVEYED: 04-01-11	DATE DRAWN: 05-10-11
PARTY L.S. S.R.L.	REFERENCES G.L.O. PLAT	
WEATHER COOL	FILE EOG RESOURCES, INC.	