




Company: US ROCKIES REGION
Site: UPRC 5-15 PAD
Wellbore: UPRC 15-4K2
Event: ABANDONMENT

Project: COLORADO-WELD
Well: UPRC 15-4K2
Design: UPRC 15-4K2

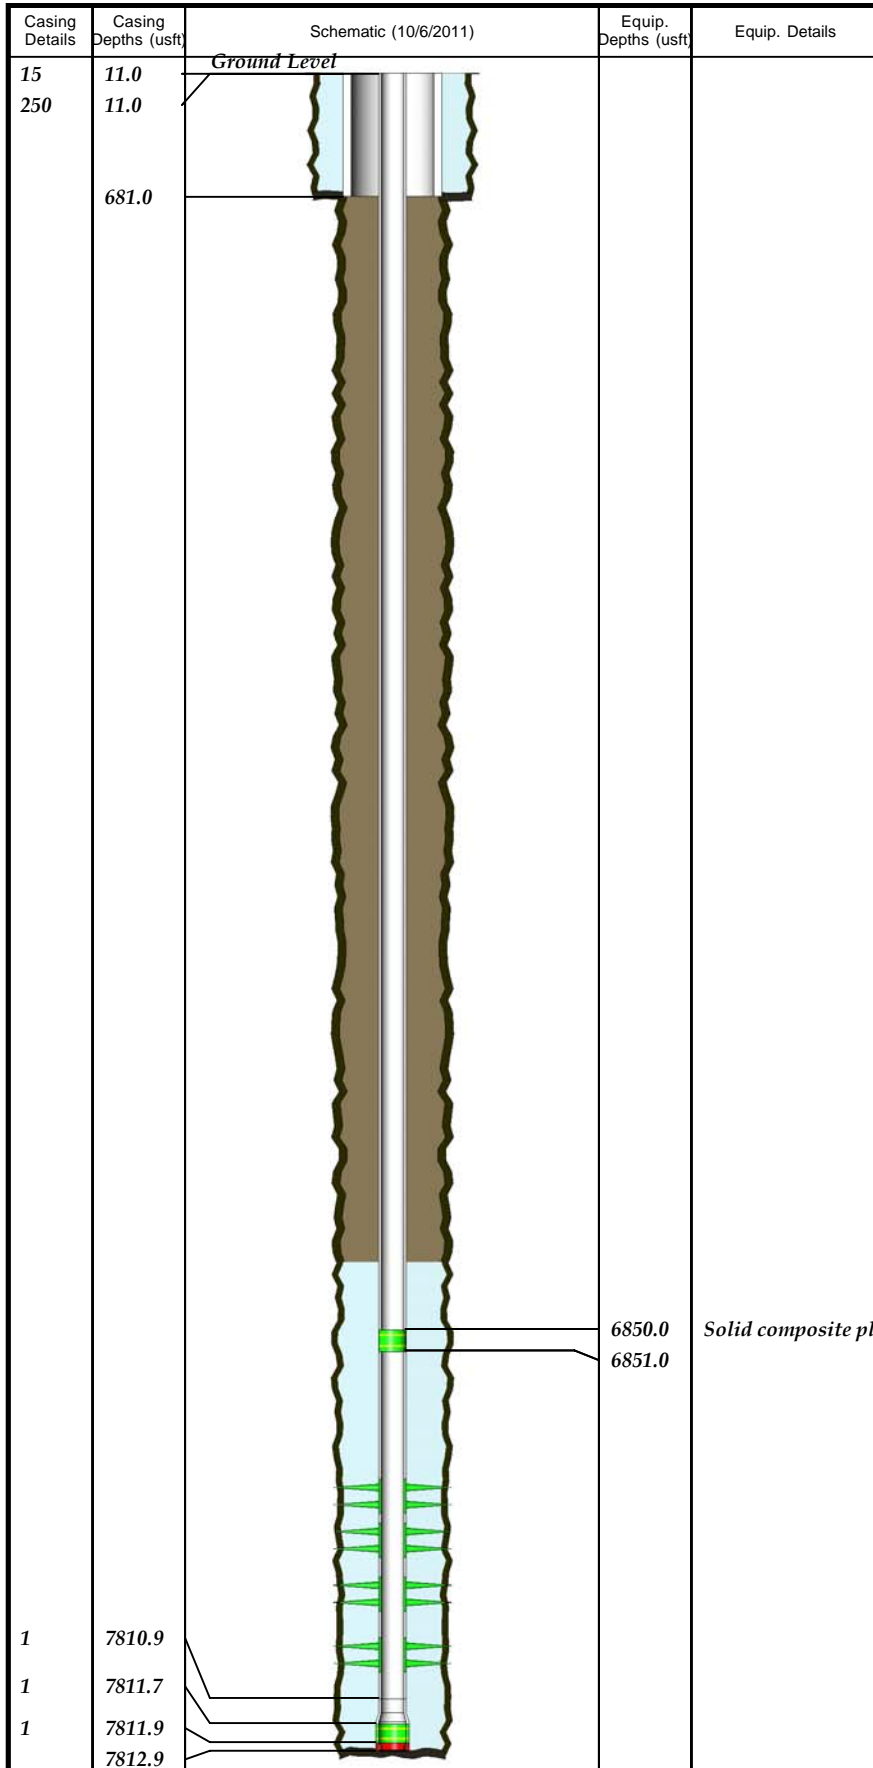

HOLE SECTIONS		
Section	MD Top (usft)	MD Base (usft)
SURFACE PRODUCTION	10.0 680.0	680.0 7,831.0

CASINGS		
Assembly Name	MD Top (usft)	Landed MD (usft)
SURFACE CASING	11.0	680.0
PRODUCTION CASING	11.0	7,812.9

WELLBORE EQUIPMENT		
Name	Top MD (usft)	Base MD (usft)
BRIDGE PLUG	6,850.0	6,851.0

REFERENCE DATUM		
RKB	@ 4,878.0usft	Default: Y

