

Job # 11152-State 1-16

Inv # 1655


High Prairie Surveying of Kiowa, Colorado has in accordance with a request from **Robert Cannon, Navex Resources Inc., Trek Resources Inc.** has determined the location of **State 1-16** to be 2108 feet FSL, and 692 feet FWL, (90° off Section lines) of SECTION **16**, Township **19s**, Range **50w** of the 6th Principal Meridian, **Kiowa County**, Colorado.

Date: Staked on 8/8/11 drawn on 8/9/11.

Re: Staked by Keith Westfall

Drawn: Drawn by Elijah Frane

Reference Area

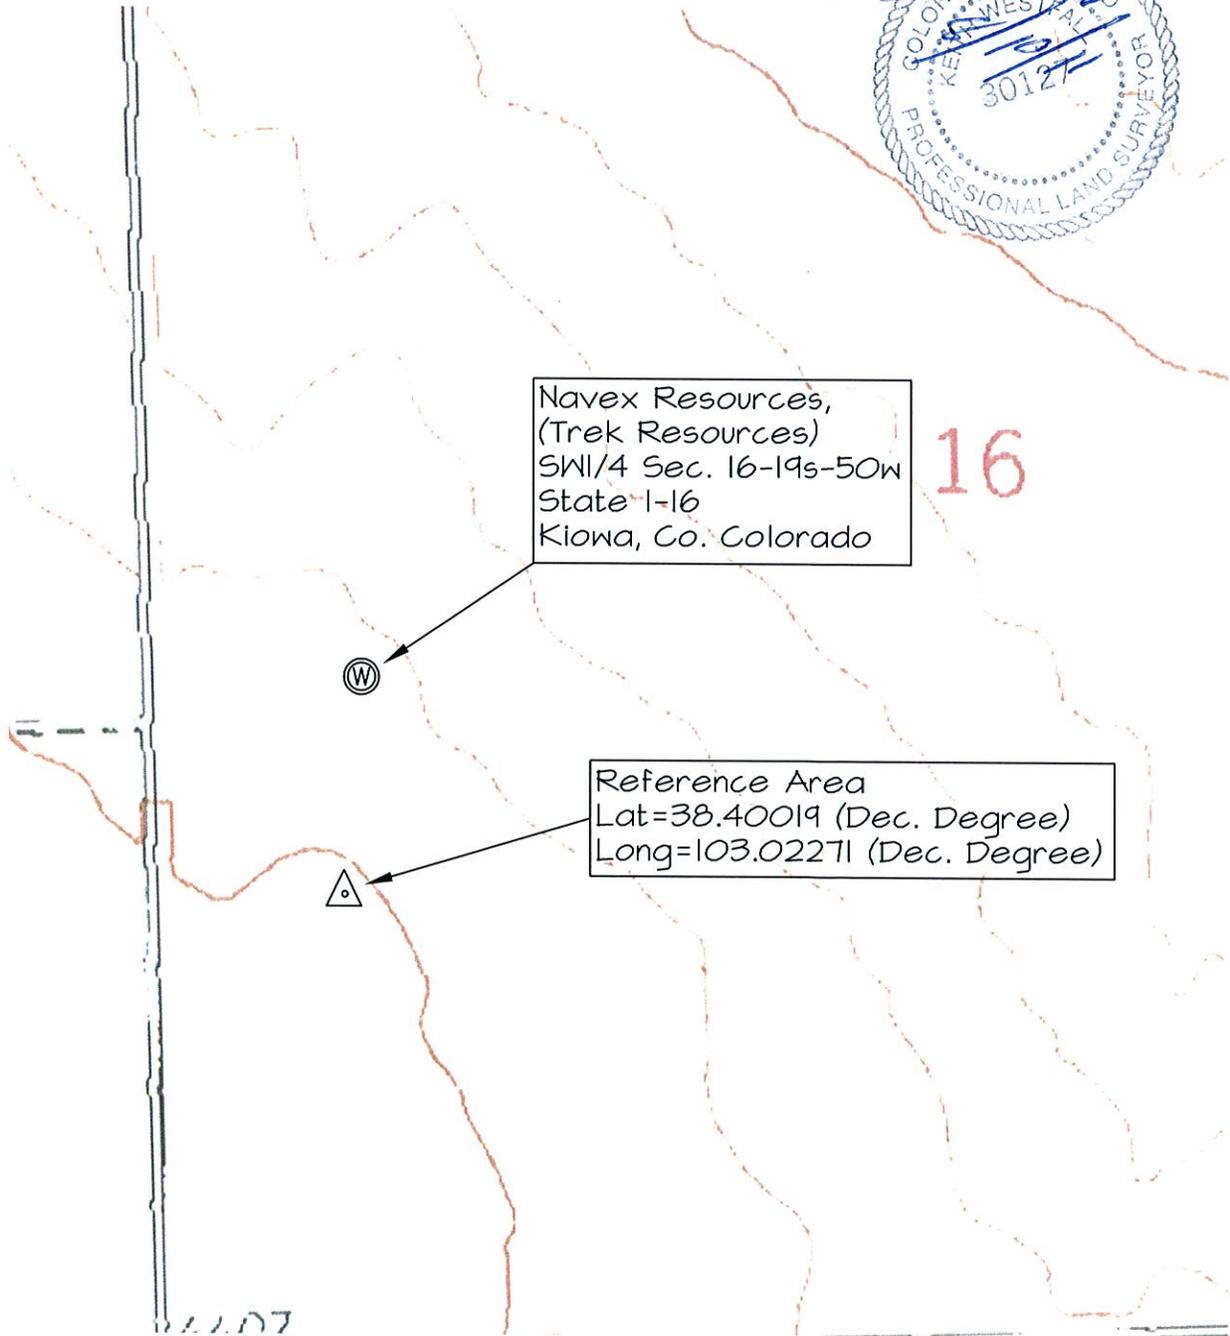

Navex Resources,
(Trek Resources)
SW1/4 Sec. 16-19s-50w
State 1-16
Kiowa, Co. Colorado

16

Reference Area
Lat=38.40019 (Dec. Degree)
Long=103.02271 (Dec. Degree)

11152