


Lat40°, Inc. 1635 Foxtrail Drive, Suite 325 Loveland, CO 970-776-3321

PRODUCTION FACILITY LOCATION DRAWING

NIX P28-69HN

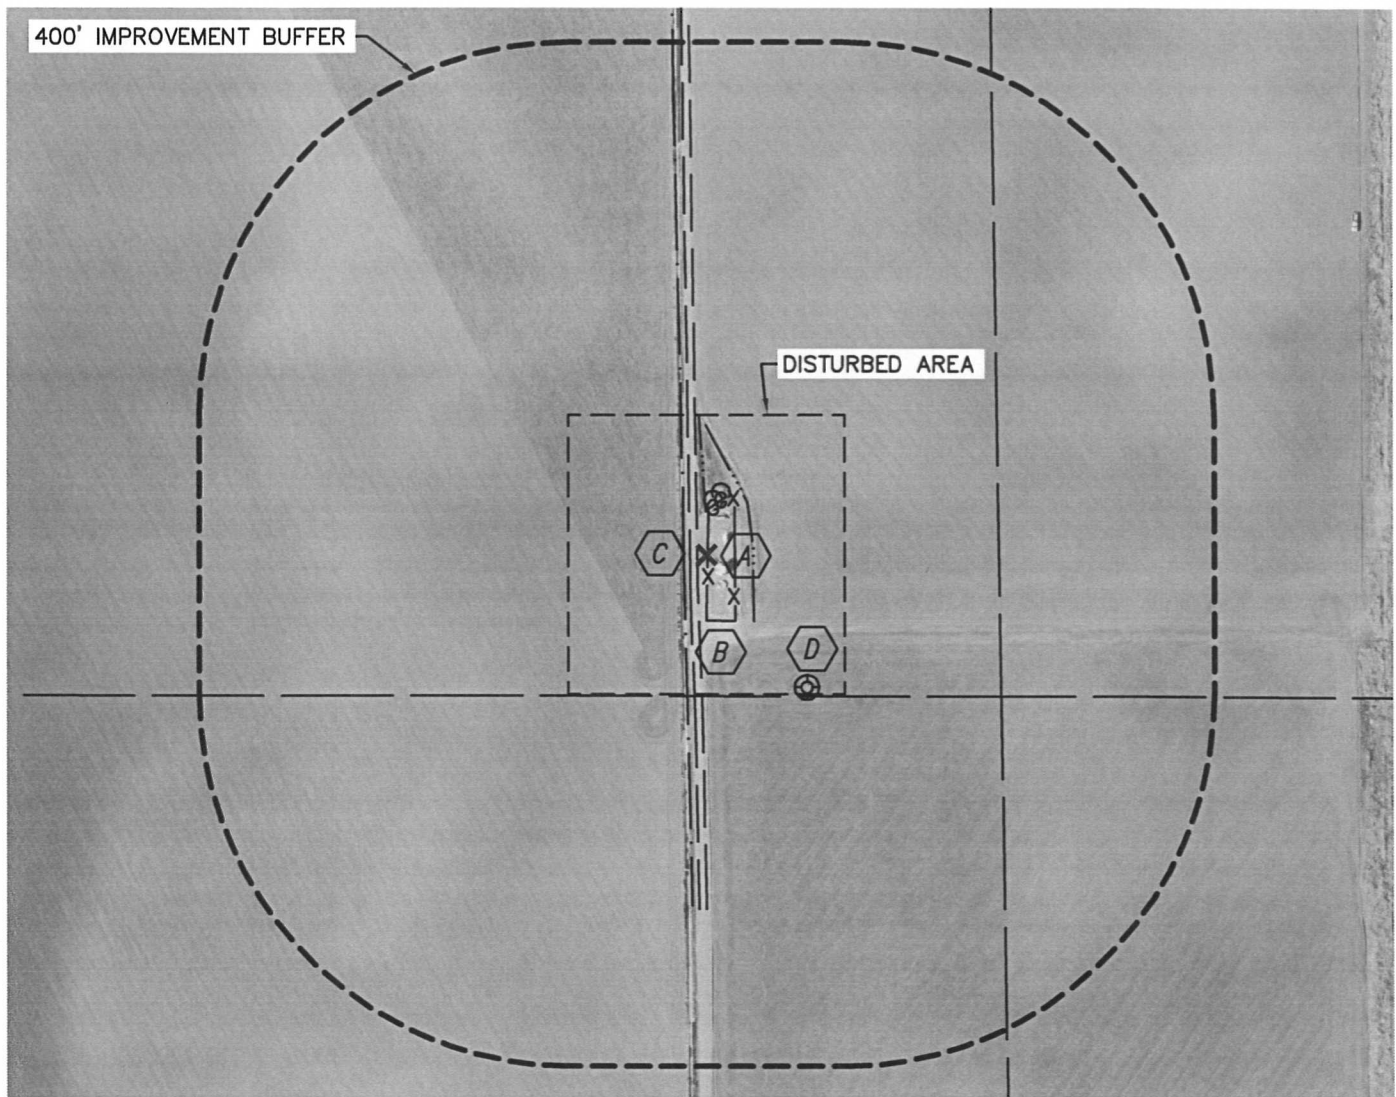



SECTION: 28
TOWNSHIP: 3N
RANGE: 67W




REFERENCE POINT LOCATION:

LATITUDE: 40.20078°N
LONGITUDE: 104.89167°W
ELEV: 4797'
PDOP: 1.5
DATE: 5/25/11
OPERATOR: ADAM KELLY
1/41/4: NW1/4NE1/4
FNL: 1165'
FEL: 1618'
DISTANCE TO WELL: 793'
ASSOCIATED NEW WELLS:
NIX P28-69HN
ASSOCIATED EXISTING WELLS:
STRONG P28-2,
RALPH NIX PRODUCE P28-2JI

IMPROVEMENTS:

-  EX. PRODUCTION EQUIPMENT (NOBLE) 2' E
-  FIELD ROAD 11' W
-  DITCH 24' W, 47' N, 50' E
-  EX. WELL 180' SE

LEGEND

 - REFERENCE POINT
ALL DISTANCES ARE APPROXIMATE.

NEAREST: BUILDING 1230' N,
PUBLIC ROAD 1150' N (HWY 66), ABOVE GROUND UTILITY 960' W,
RAILROAD 2850' NW (ABANDONED), PROPERTY LINE 983' W

