


Lat40°, Inc. 1635 Foxtrail Drive, Suite 325 Loveland, CO 970-776-3321

PRODUCTION FACILITY LOCATION DRAWING

BOOTH CC31-13

SECTION: 31
TOWNSHIP: 4N
RANGE: 63W

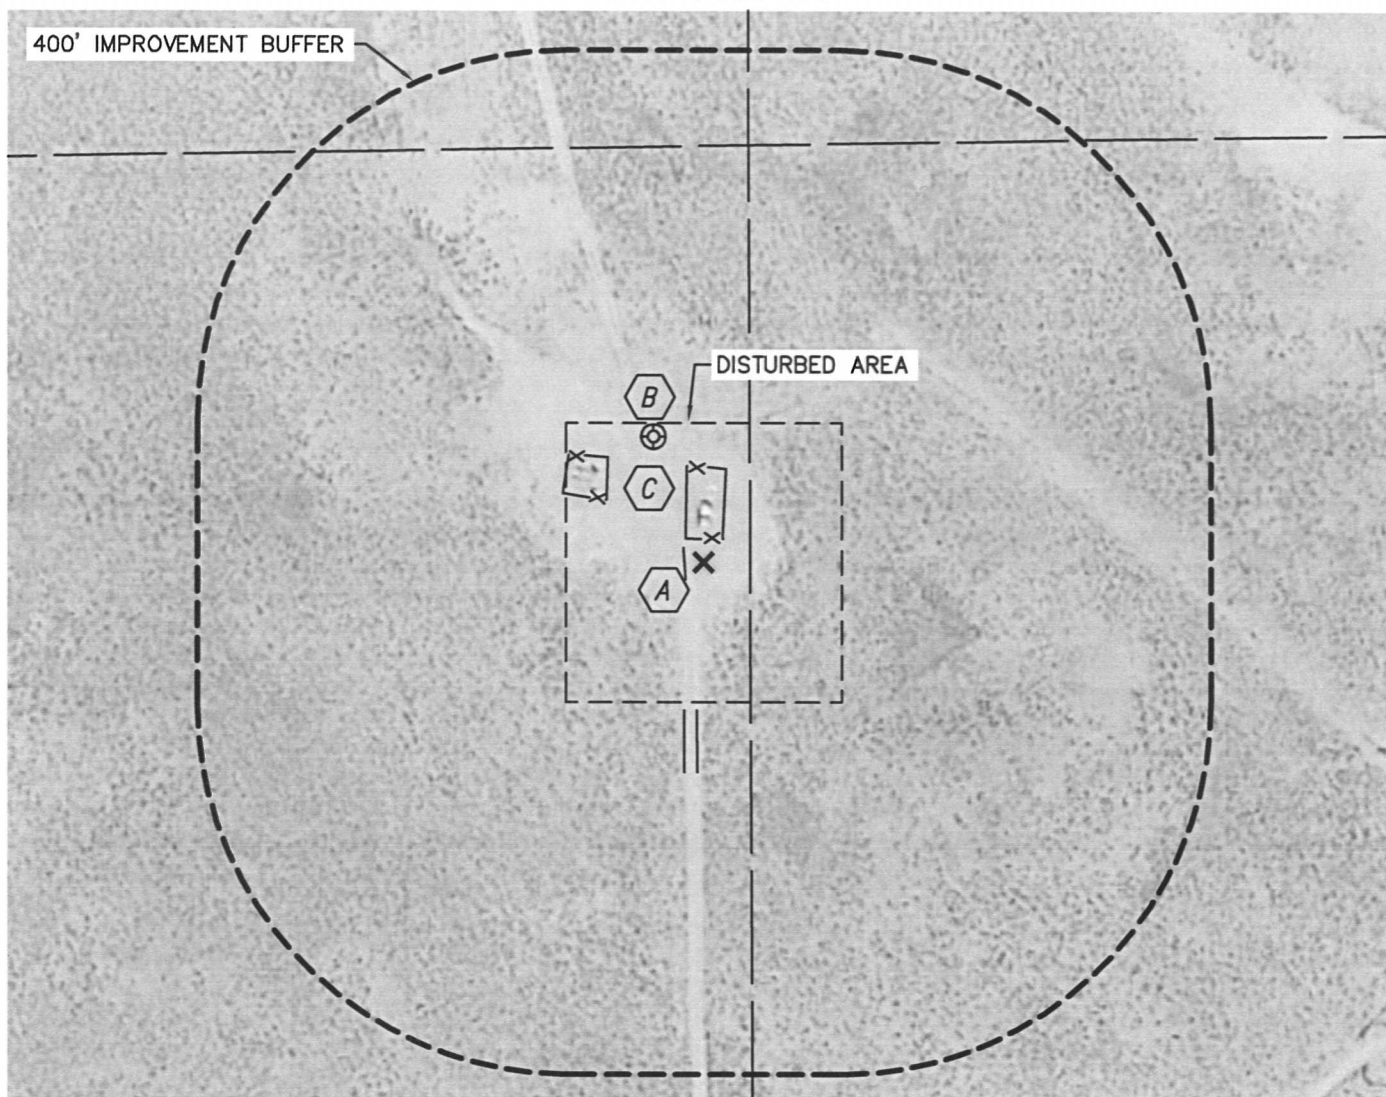

REFERENCE POINT LOCATION:

LATITUDE: 40.26410°N
LONGITUDE: 104.48544°W
ELEV: 4855'
PDOP: 1.6

DATE: 8/10/2011
OPERATOR: ADAM KELLY
1/41/4: SW1/4SW1/4
FSL: 861'
FWL: 1257'




DISTANCE TO WELL: 515'
ASSOCIATED NEW WELLS:

BOOTH CC31-13


ASSOCIATED EXISTING WELLS:

UPV 31-1313
SADIE CC31-11
SADIE CC31-12
SADIE CC31-14

IMPROVEMENTS:

-  FIELD ROAD 21' W
-  EX. WELL (UPV 31-1313) 146' NW
-  EX. PRODUCTION EQUIPMENT (NOBLE ENERGY) 25' N, 125' NW

LEGEND

 - REFERENCE POINT
ALL DISTANCES ARE APPROXIMATE.

NEAREST: BUILDING 5280'+,
PUBLIC ROAD (CR 57) 5280'+ W, ABOVE GROUND UTILITY 5280'+,
RAILROAD 5280'+, PROPERTY LINE 861' S

