

City and County of Denver

Date: 04/28/2009
 Prepared by: JMB
 Well Name: Monaghan 2
 Field: Wattenberg
 Legal: NWNE Sec. 10 T2S R65W

Geological tops


Niobrara 7,282'
 D Sand 7,942'
 J Sand 8,085'

County: Denver
 State: Colorado
 GL: 5,289'
 KB: 5,277'
 API: 05-031-06477

Spud date: 03/28/1972
 Completion date: 06/10/1972
 Producing zone: J Sand

Hole Size: 12 1/4"
 Surface Casing: 8 5/8" 24#
 Cement Volume: 150 sx

Surface Casing Shoe

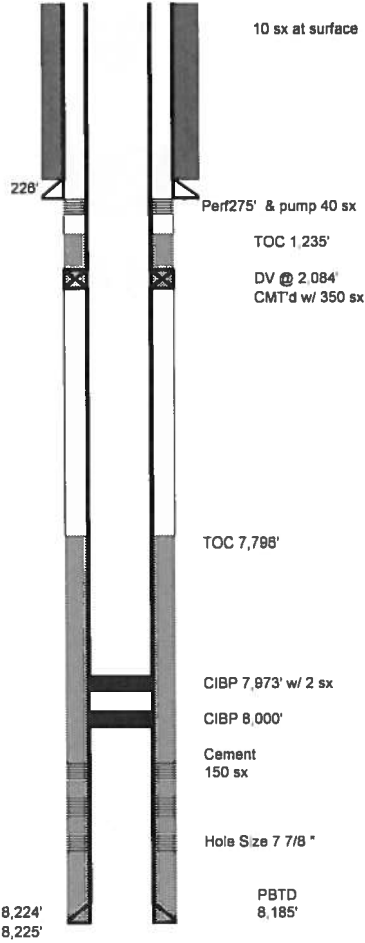

Pump 40 sx plug 2,142 - 2,042' tagged at 168'

Production Casing: 5 1/2 15 5 & 17#

Perforations

J Sand 8,100 - 8,125'
 2SPF

1,000 gals 15% MCA, 26,000 gal My-T Oil