


WELL LOCATION CERTIFICATE

AVEY 41-9

N.W. COR. SEC. 9
FND. 3 1/4" ALUM. CAP
LS 13155

WCR 12 GRAVEL
R 66W

N.E. COR. SEC. 9
FND. 2" ALUM. CAP
ALPHA SURVEYING

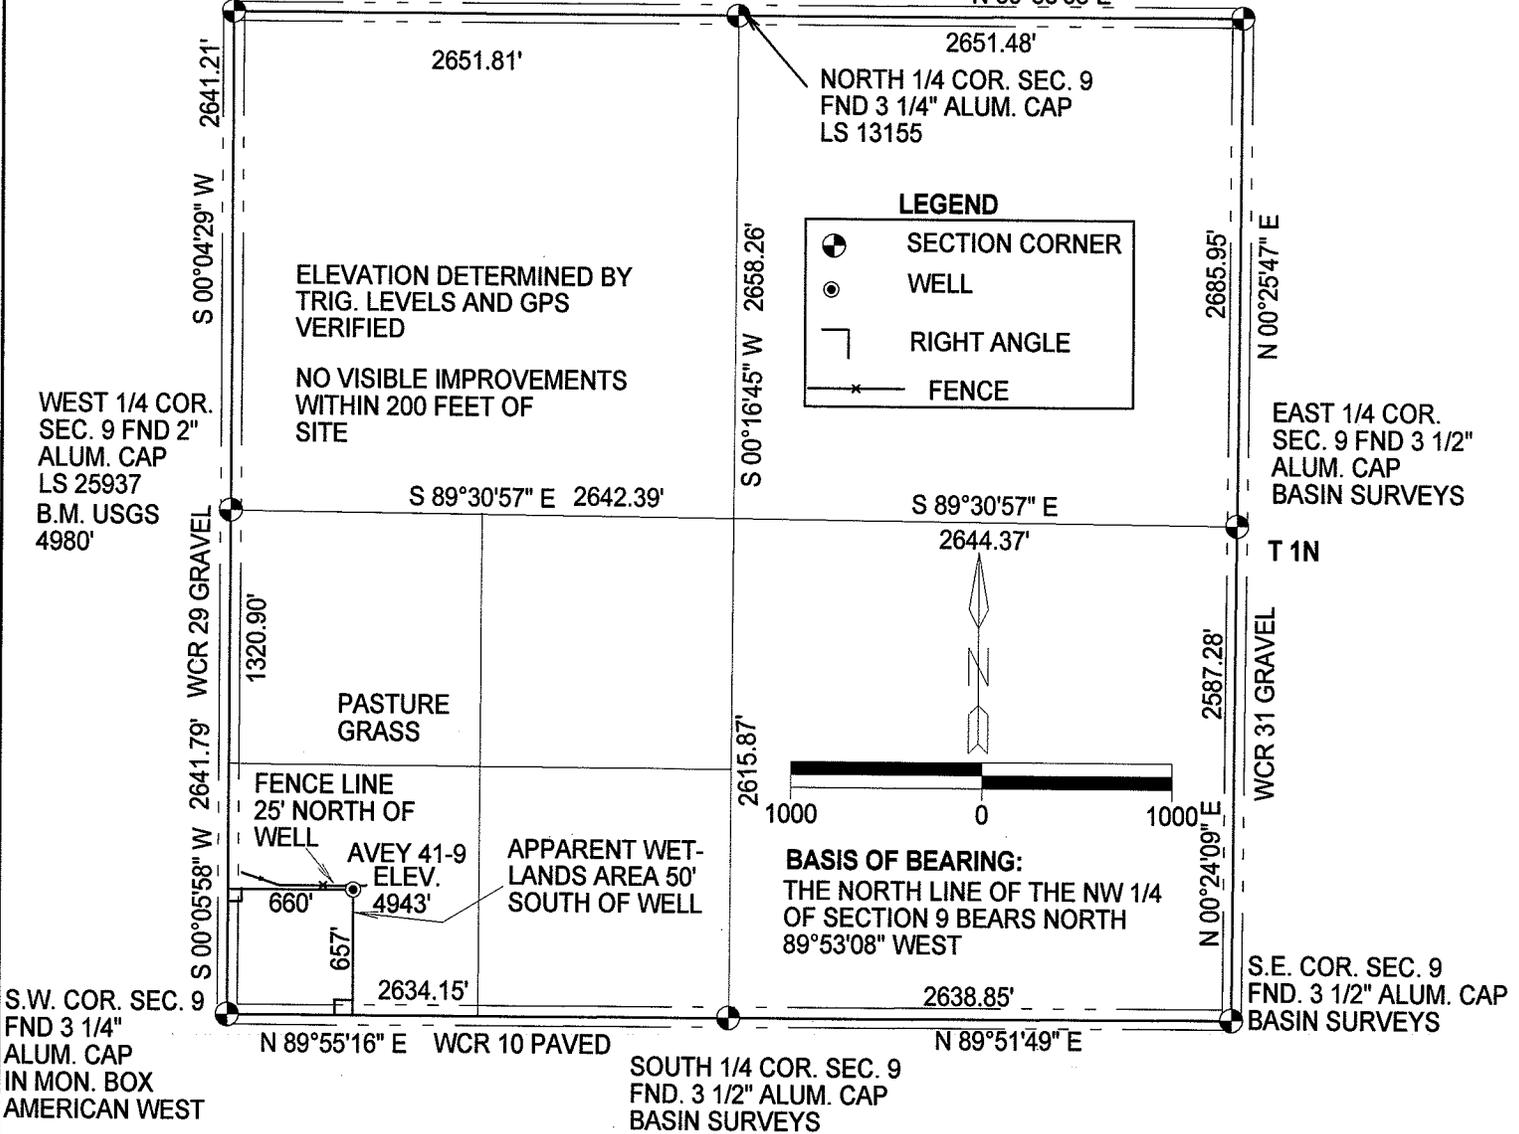

LEGEND

- SECTION CORNER
- WELL
- RIGHT ANGLE
- FENCE



BASIS OF BEARING:
THE NORTH LINE OF THE NW 1/4
OF SECTION 9 BEARS NORTH
89°53'08" WEST

GPS LOCATION	
NORTH	40.06026° NAD 1983
WEST	104.78926°
PDOP	4.3

IN ACCORDANCE WITH A REQUEST FROM MERIT ENERGY COMPANY, THE UNDERSIGNED HAS DETERMINED THE LOCATION OF THE AVEY NUMBER 41-9 WELL TO BE 660' FWL AND 657' FSL, SECTION 9, TOWNSHIP 1 NORTH, RANGE 66 WEST OF THE 6TH PRINCIPAL MERIDIAN, WELD COUNTY, COLORADO. FIELD SURVEY DATE: FEBRUARY 6, 2007

SURVEYOR STATEMENT


I, ROBERT D. THOMAS DO HEREBY STATE THAT THIS OIL AND, OR GAS WELL LOCATION CERTIFICATE WAS PREPARED FOR MERIT ENERGY COMPANY. IT IS NOT A SURVEY PLAT OR IMPROVEMENT SURVEY PLAT AND IS NOT TO BE RELIED UPON FOR THE ESTABLISHMENT OF FENCES, BUILDINGS OR OTHER FUTURE IMPROVEMENT LINES.

Feb. 7, 2007

DATE

Robert D. Thomas

ROBERT D. THOMAS
COLORADO REGISTERED LAND SURVEYOR
NUMBER 11399

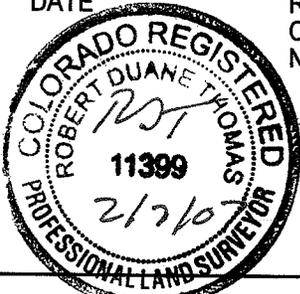

THOMAS SURVEY SERVICES, LLC
2619 WEST 11TH STREET ROAD, SUITE 24
GREELEY, COLORADO 80634
TELEPHONE: (970) 304-0984

PROJECT: 0611.021
DRAWING: MERIT AVEY 41-9