


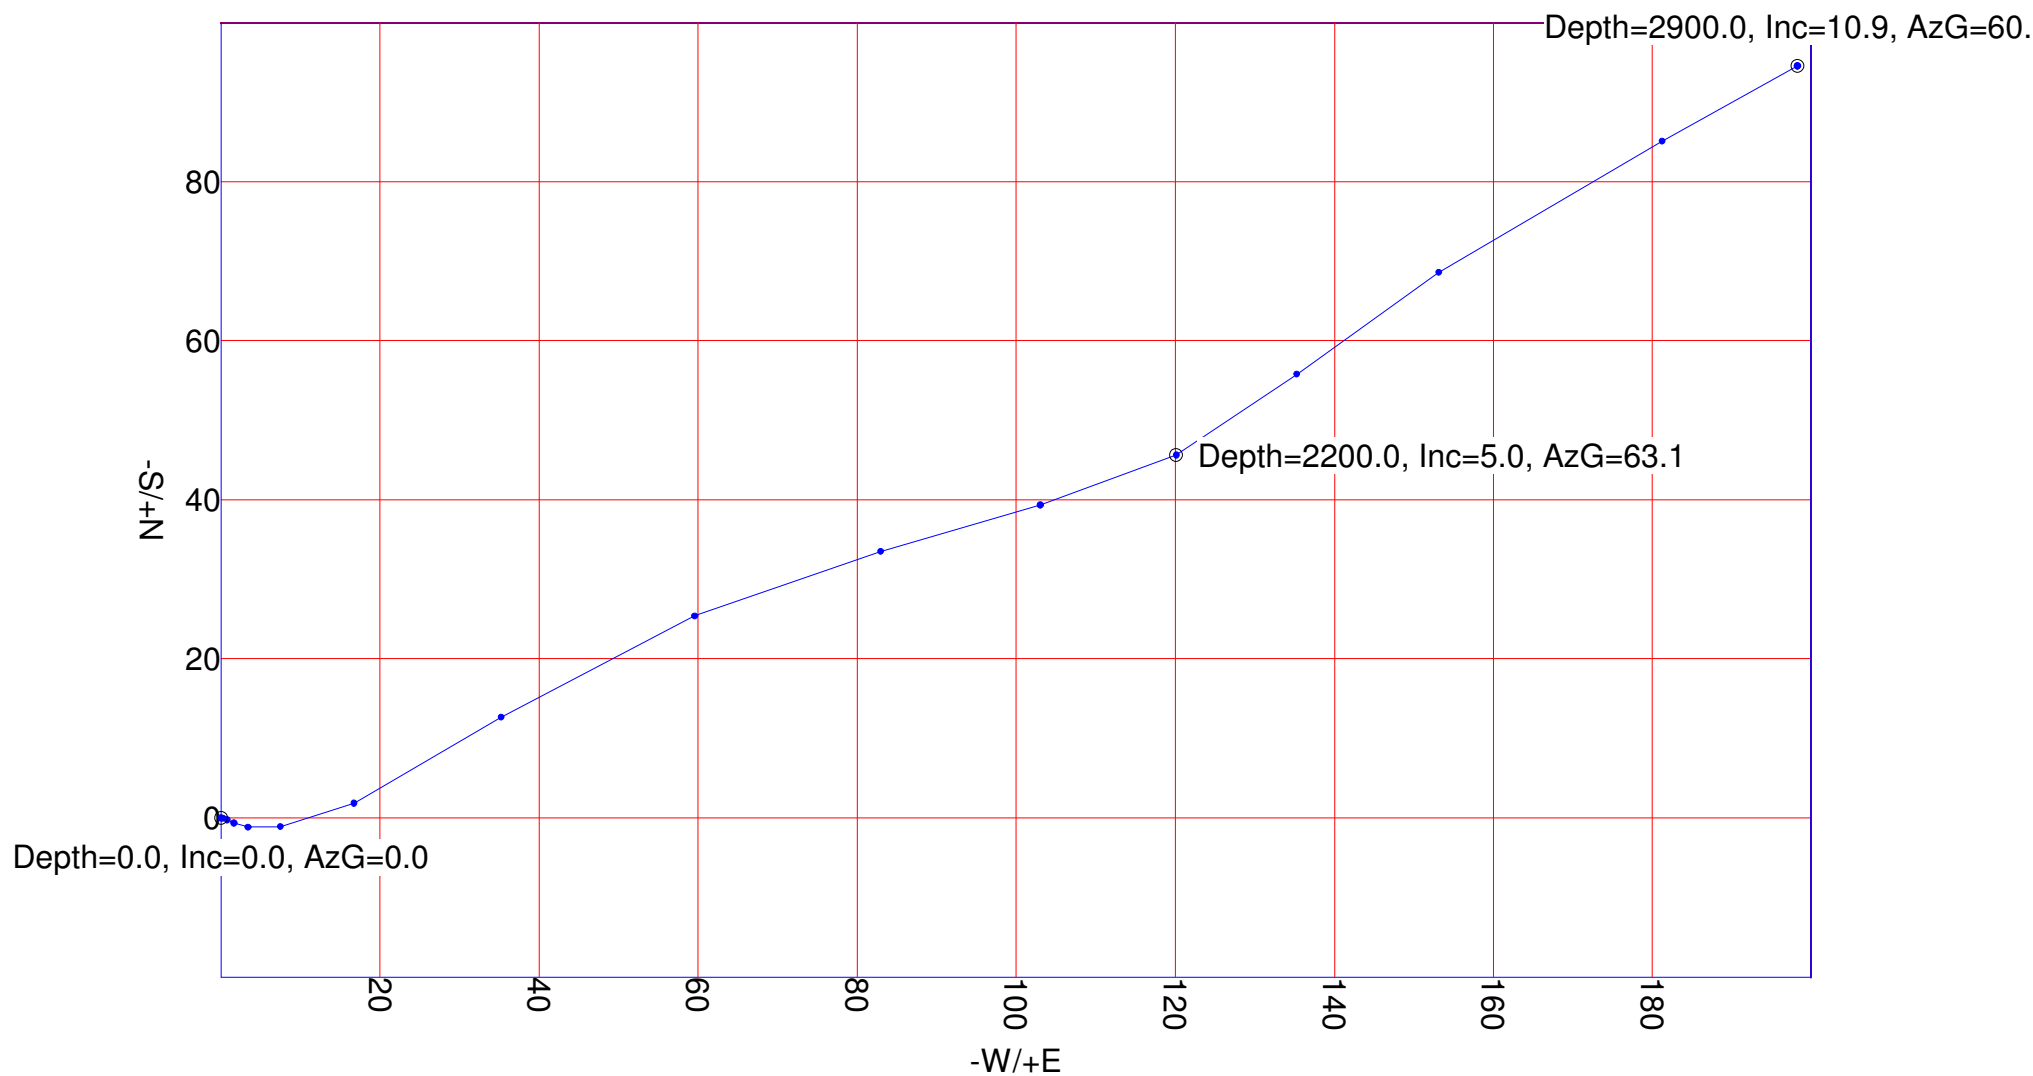

Vaughn Energy Services
Rifle, Colorado
970 456 2071
Surveyor: S. Anderson
PCU 55-9



V.E.S.