



Corporate Office

1775 Sherman Street, #3000
Denver, Colorado 80203
303.860.5800
www.petd.com

October 11, 2011

Department of Natural Resources
Oil and Gas Conservation Commission
The Chancery Building
1120 Lincoln St., Suite 801
Denver, CO 80203

Re: **30 Day Certification Letter – Rule 318Ae**
Moss 14-16H
Township 7 North, Range 65 West, 6th PM
Section 16: SWSW
Weld County, Colorado

Dear Director,

Petroleum Development Corporation doing business as PDC Energy (“PDC”) hereby certifies to the Director that a thirty (30-day) notice has been given by certified mail to all owners in the proposed wellbore spacing unit consisting of the S2S2 of Section 16 T7N R65W, 160 acres. We have not received any objections to such well location or proposed spacing unit, therefore PDC hereby requests the Director to approve the infill well.

If you should have any questions or concerns regarding this permit, please contact the undersigned at (303) 860-5800.

Sincerely,


A handwritten signature in blue ink, appearing to read "Liz Lindow".

Liz Lindow
Regulatory Analyst
PDC Energy

WELL LOCATION CERTIFICATE

SECTION 16, TOWNSHIP 7 NORTH, RANGE 65 WEST, 6TH P.M.


NE SEC. 16
3.25" AC LS 22098

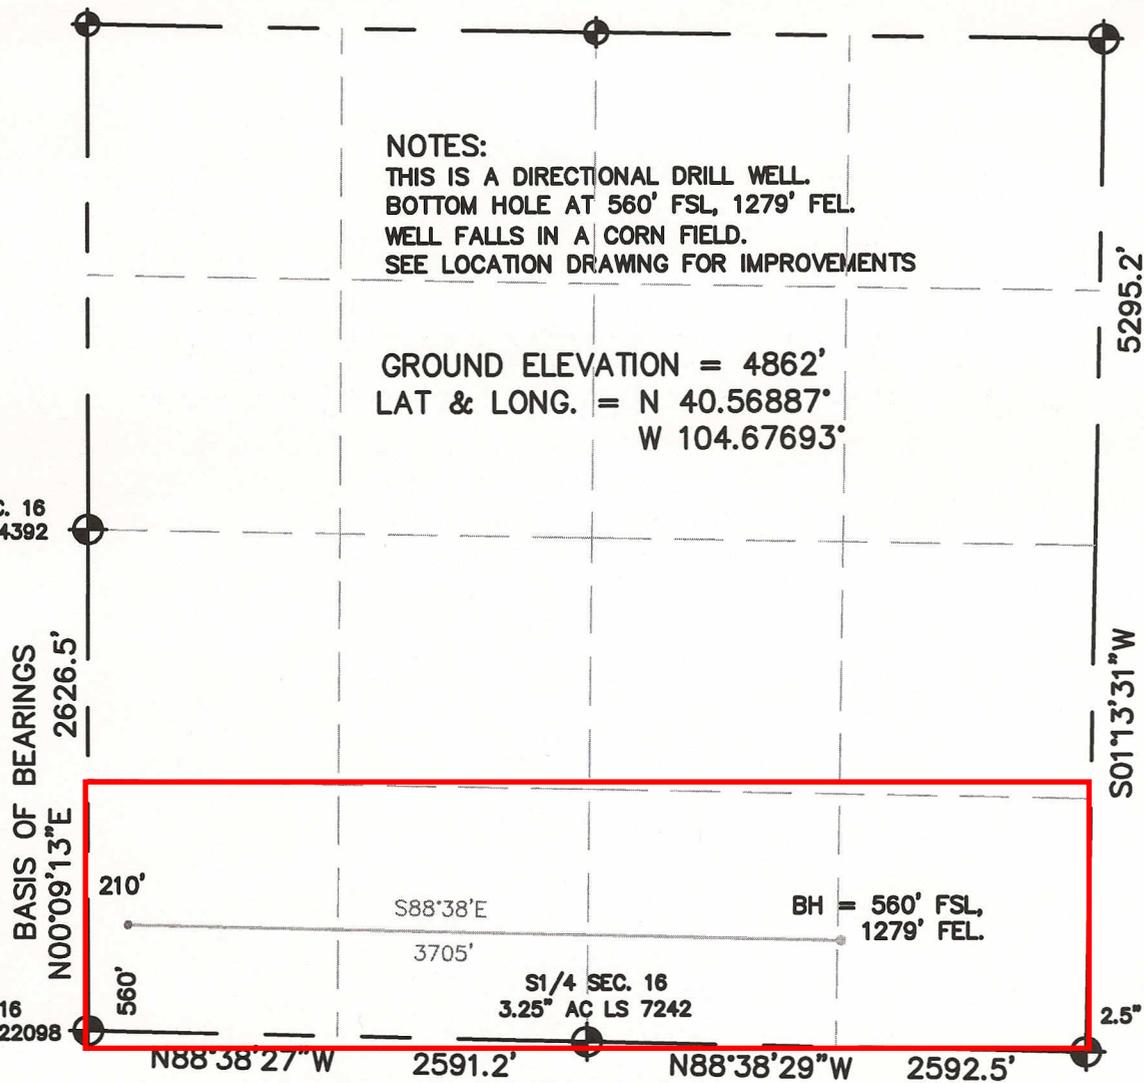


NOTES:
 THIS IS A DIRECTIONAL DRILL WELL.
 BOTTOM HOLE AT 560' FSL, 1279' FEL.
 WELL FALLS IN A CORN FIELD.
 SEE LOCATION DRAWING FOR IMPROVEMENTS

GROUND ELEVATION = 4862'
 LAT & LONG. = N 40.56887°
 W 104.67693°

I HEREBY STATE TO PETROLEUM DEV. CORP. THAT THIS WELL LOCATION CERTIFICATE FOR THE WELL MOSS 14-16H IS LOCATED 560' FSL & 210' FWL, SEC. 16, T7N, R65W, 6PM.

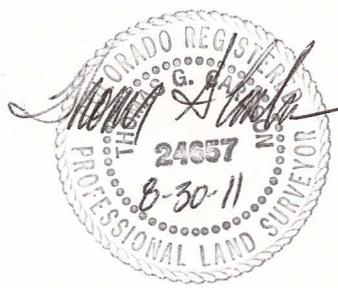

- LEGEND**
- = FOUND MONUMENT
 - = PROPOSED WELL
 - = BOTTOM HOLE

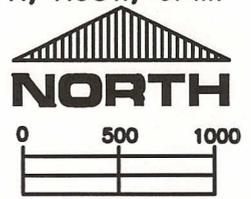

SCALE 1" = 1000'
 ELEVATION SOURCE = USGS 7.5' QUAD.MAP CONTOURS
 NGVD 1929 DATUM.
 LAT. & LONG. ARE DIFFERENTIALLY CORRECTED (NAD'83)
 USING (DGPS) WITH A (PDOP) VALUE OF 2.0.

THOMAS G. CARLSON, PLS 24657
 HORSESHOE SURVEYING, LLC

SHOWN DISTANCES ARE FIELD MEASURED - EXTERIOR SECTION LINES ARE DRAWN TO SCALE (BEST APPROX. OR FOUND MONUMENT).

THIS IS NOT A MONUMENTED BOUNDARY SURVEY, IT IS ONLY A DRAWING INTENDED TO DEPICT THE WELL LOCATION TO SECTION LINES.

DISTANCES TO WELL SHOWN PERPENDICULAR TO SECTION LINES.

PREPARED BY: HORSESHOE SURVEYING, LLC PO BOX 150458 LAKEWOOD, CO 80215 (720)872-0196		WELL NAME: MOSS 14-16H	
DRAWING DATE: 8-30-11		LOCATION: WELD COUNTY, CO SW1/4, SEC. 16, T7N, R65W, 6TH P.M.	
FIELD DATE: 8-27-11	BY: TGC	CHKD:	JOB NO. SHEET NO. 1 OF 1