


Osborn 3

Current Configuration


Form 6 Intent

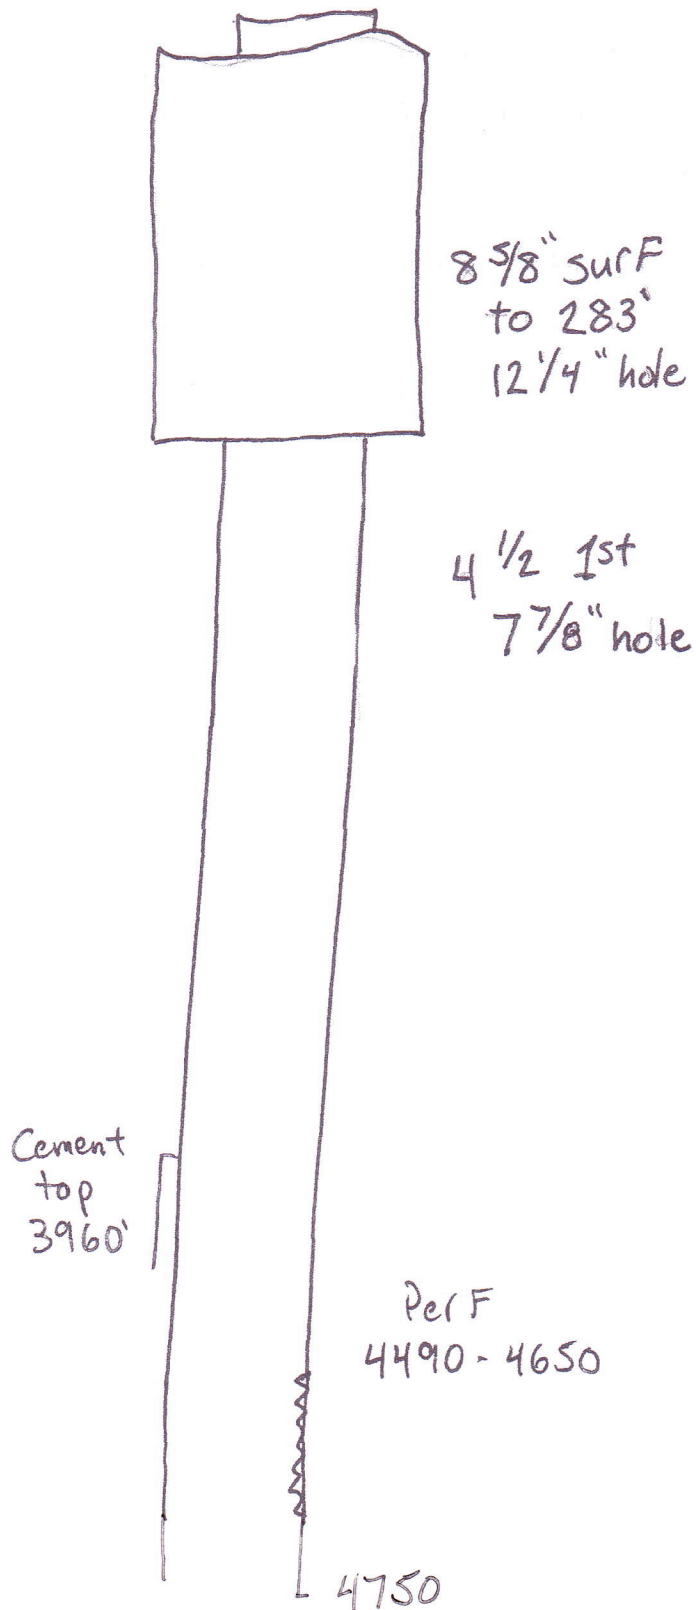

Osborn 3

PA Configuration

Form 6

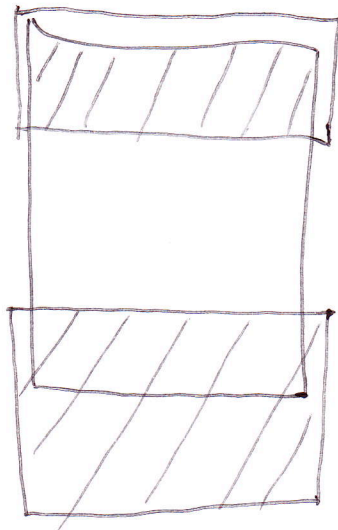


10 sx at Surf

50 sx plug

1/2 in 1/2 out

from 370' - 200'

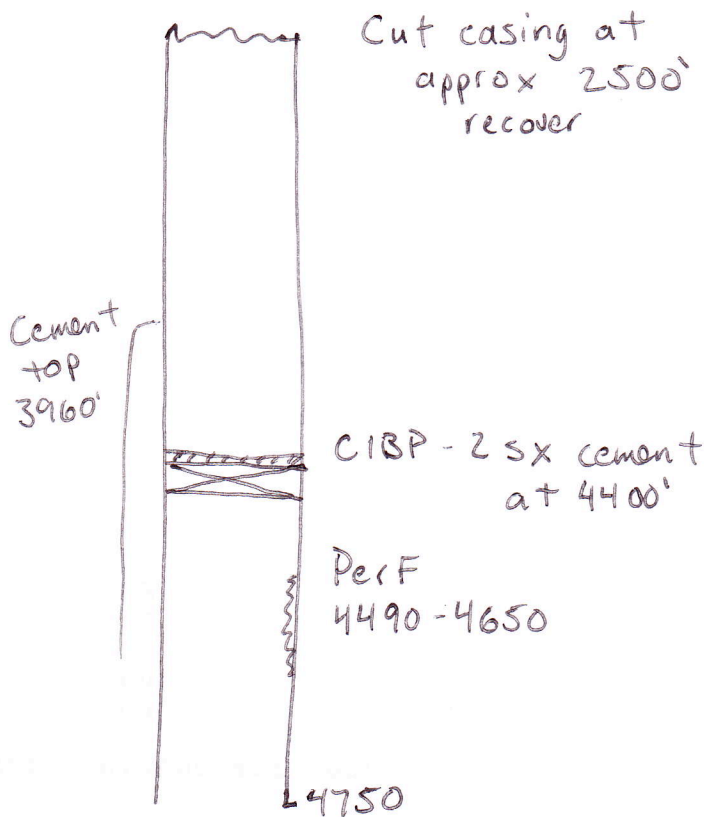

Cut casing at  
approx 2500'  
recover

Cement  
top  
3960'

CIBP - 2 sx cement  
at 4400'

Perf  
4490-4650

4750