


PA Diagram - Current Ward Boyd Brose

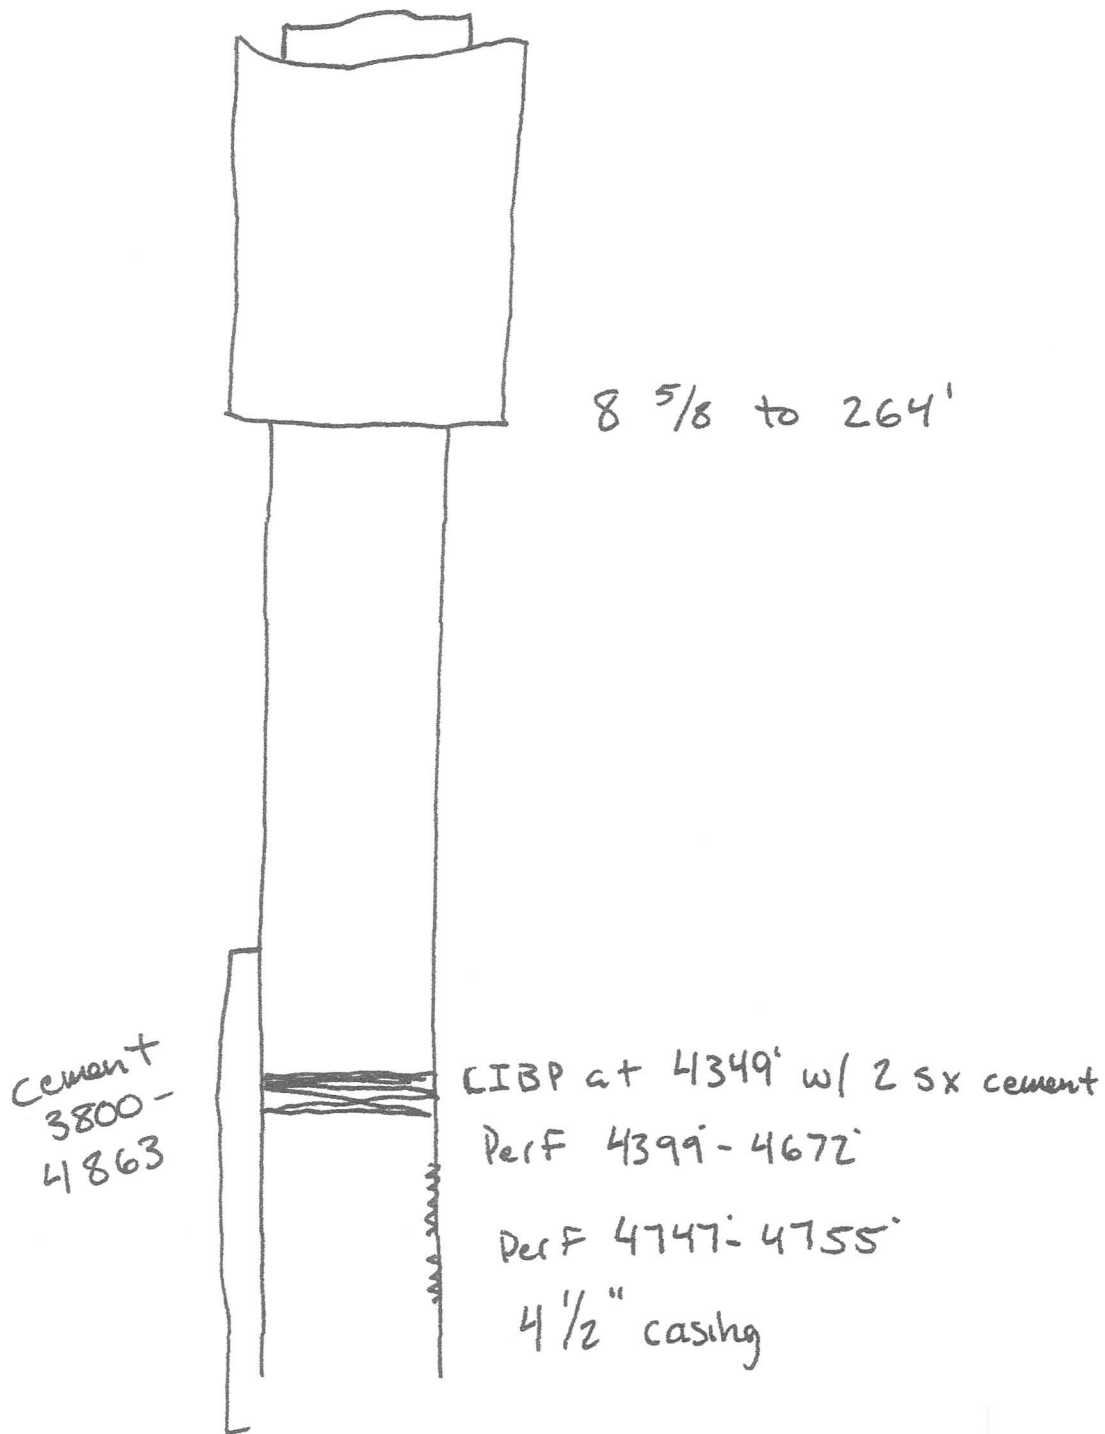

PA Diagram - Planned Ward Boyd Brose

