


PRODUCTION FACILITY HYDROLOGY MAP

CANNON H35-11

SECTION 35, TOWNSHIP 3 NORTH, RANGE 65 WEST OF THE 6TH PRINCIPAL MERIDIAN

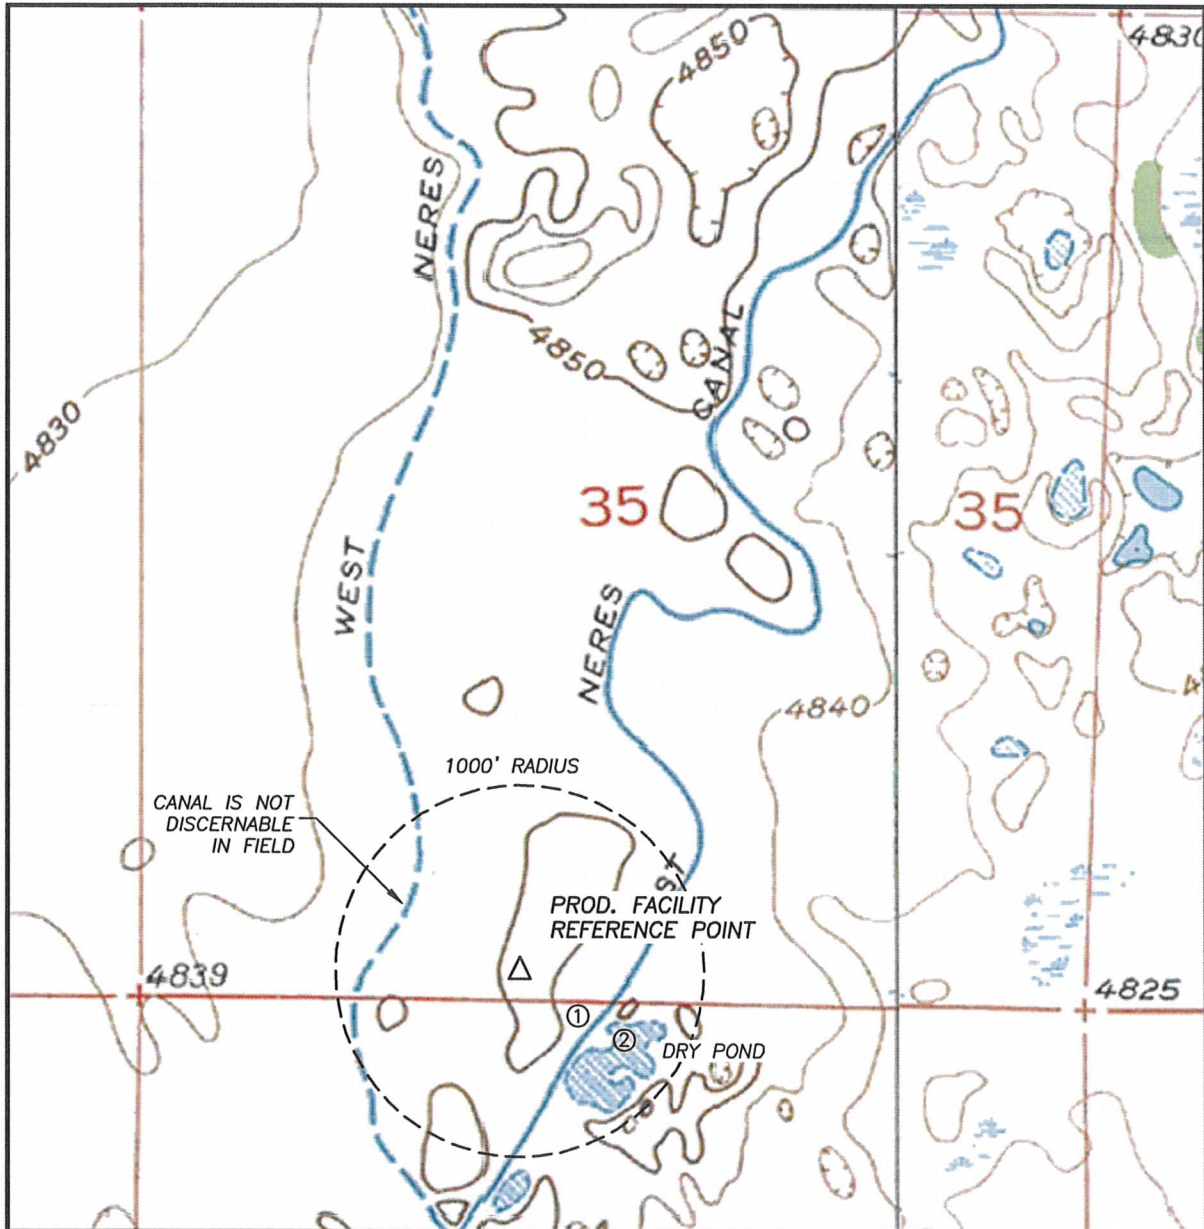

SURFACE WATER

1. CANAL: 513'± SE
2. DRY POND: 575'± SE

