Jolley Family LLLP KP 514-9

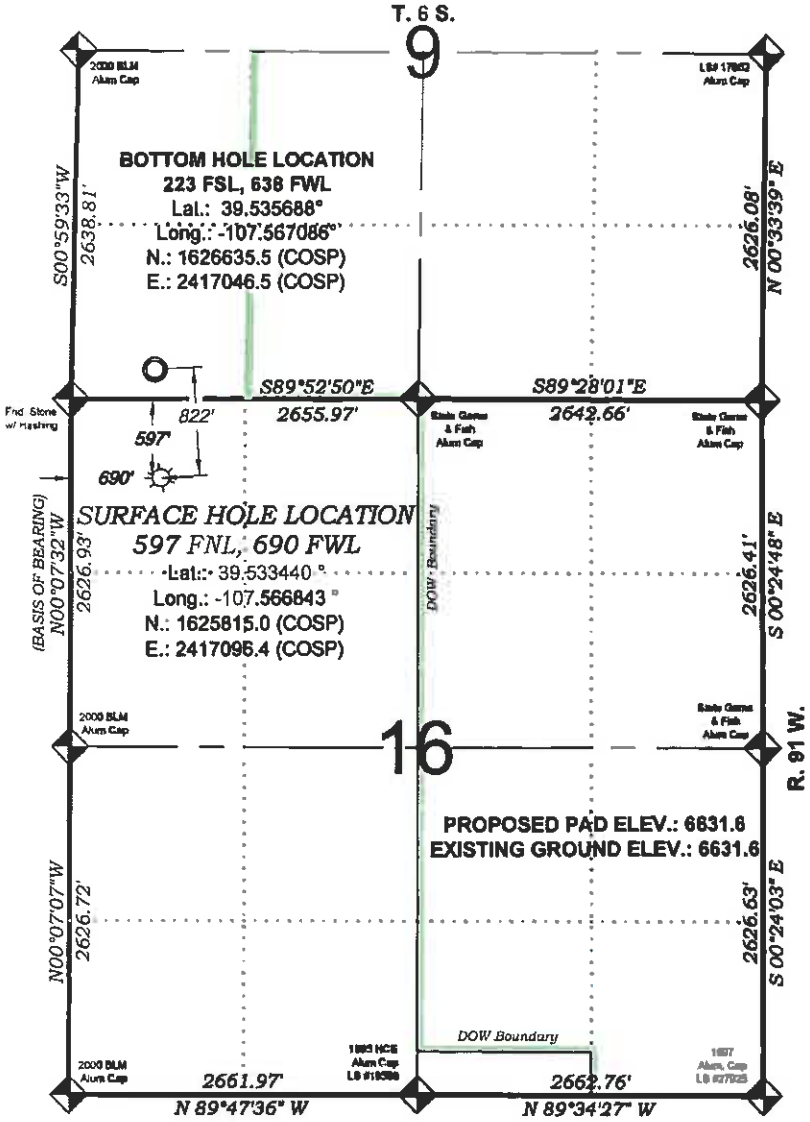

THERE ARE NO VISIBLE IMPROVEMENTS WITHIN 400' OF THIS LOCATION

700 0 1400
GRAPHIC SCALE IN FEET
1 INCH = 1400 FEET

- LEGEND -

FIELD LOCATED SECTION MONUMENTS AS DESCRIBED

FIELD SURVEYED WELL LOCATION

CALCULATED BOTTOM HOLE LOCATION

CALCULATED SECTION CORNER LOCATION

SURVEYORS STATEMENT

I, MICHAEL J. LANGHORNE, A REGISTERED LAND SURVEYOR IN THE STATE OF COLORADO DO HEREBY CERTIFY THAT THE SURVEY SHOWN HEREON WAS PREPARED UNDER MY DIRECT SUPERVISION AND HAS BEEN STAKED ON THE GROUND AS SHOWN ON THE PLAT AND CHECKING THAT THIS MAP IS A TRUE REPRESENTATION THEREOF.

MICHAEL J. LANGHORNE, COLORADO REGISTRATION NO. 36572
FOR AND ON BEHALF OF:
BOOKCLIFF SURVEY SERVICES, INC.

NOTES

1) *ELEVATIONS BASED ON N.A.V.D. 1988 PUBLISHED COORDINATES.*
2) *LATITUDES AND LONGITUDES ARE BASE ON NAD 83, PUBLISHED COORDINATES*
3) *STATE PLANE COORDINATES ARE BASED ON COLORADO CENTRAL ZONE, U.S. SURVEY FEET.*
4) *ELEVATION MASK SET TO 15°*
5) *GPS OPERATOR J. KIRKPATRICK, OBSERVED A PDOP OF 0.8 FOR SURVEY POINT NUMBER 72000.*
6) *SURFACE AND BOTTOM HOLE LOCATIONS ARE MEASURED 90° FROM SECTION LINES.*

REFERENCES

1) *DEPENDENT RESURVEY T. 6 S., R. 91 W., 6 th P.M (GLO NOTES)*
2) *U.S.G.S. QUAD: NEW CASTLE, CO*

REVISED: 10/3/11

SURVEY DATE:	*12/14/09*
MAP DATE:	*2/4/11*
SCALE:	*1" = 1400'*
PLAT:	*1 of 1*
PROJECT:	*Williams Kokopelli*

BOOKCLIFF Survey Services, Inc.

WELL LOCATION PLAT Prepared for:
Williams. Williams Production, RMT

NW1/4 NW1/4, SECTION 16
T. 6 S., R. 91 W. of the 6th. P.M.
GARFIELD COUNTY, COLORADO