


LEGEND

- FOUND MONUMENT (AS DESCRIBED)
- WELL LOCATION

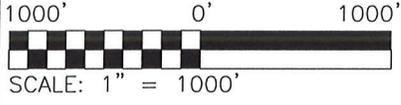

IN ACCORDANCE WITH A REQUEST FROM CONOCO PHILLIPS COMPANY, CVL CONSULTANTS OF COLORADO INC. HAS DETERMINED THE SURFACE LOCATION OF THE TEBO 32-1 WELL TO BE 2728.30' FSL, AND 1472.44' FWL, AS MEASURED AT NINETY (90) DEGREES FROM THE SECTIONS LINES OF SECTION 32, TOWNSHIP 4 SOUTH, RANGE 64 WEST OF THE 6TH PRINCIPAL MERIDIAN, ARAPAHOE COUNTY, COLORADO.

NAD 83 LATITUDE AND LONGITUDE
 LATITUDE: 39°39'35.48386"N
 LONGITUDE: 104°34'45.21433"W
 ELEVATION: 5926.48'
 FOOTAGE: 2728.30' FSL, 1472.44' FWL
 PDOP: 2.1
 QTR/QTR: SE4/NW4
 PROP LINE: 1472.44' WEST
 GPS OPERATOR: CHRISTIAN D. LIPSCOMB

I HEREBY CERTIFY THAT THIS WELL LOCATION CERTIFICATE WAS PREPARED BY ME OR UNDER MY DIRECT SUPERVISION, THAT THE WORK WAS COMPLETED ON SEPTEMBER 22, 2011 FOR AND ON BEHALF OF CONOCO PHILLIPS COMPANY, AND THAT THIS MAP DOES NOT REPRESENT A BOUNDARY SURVEY, IT IS NOT A LAND SURVEY PLAT OR AN IMPROVEMENT SURVEY PLAT AND IT IS NOT TO BE RELIED UPON FOR THE ESTABLISHMENT OF FENCE, BUILDING OR OTHER FUTURE IMPROVEMENT LINES.



- NOTES:**
1. BEARINGS FOR THIS MAP ARE ASSUMED AND BASED UPON GPS OBSERVATIONS MADE BETWEEN THE MONUMENTS LOCATED AT THE SOUTHWEST CORNER AND THE WEST QUARTER CORNER OF SECTION 32, T.4S., R.64W. SAID LINE IS ASSUMED TO BEAR N 00° 49' 57" E (BASIS OF BEARING), AS SHOWN HEREON.
 2. HORIZONTAL DATUM IS WGS 84
 3. VERTICAL DATUM IS NAVD 88. ELEVATIONS ARE DERIVED FROM NGS BM INDIAN, PID # KK1656, ELEVATION = 6066.54 FT
 4. SURFACE USE: AGRICULTURAL.

FOR AND ON BEHALF OF
 CVL CONSULTANTS OF COLORADO, INC.
 DALLAS W. WILSON, PLS NO. 38058

NOTICE: According to Colorado law you MUST commence any legal action based upon any defect in this W.L.C. within three years after you first discover such defect. In no event may any action based upon any such defect in the W.L.C. be commenced more than ten years from the date of the certification shown hereon.

WELL LOCATION CERTIFICATE
TEBO 32-2

SECTION 32, TOWNSHIP 4 SOUTH, RANGE 64 WEST, OF THE 6TH PM

7901 E. Belleview Avenue
 Suite 150
 Englewood, CO 80111
 Tel: (720) 482-9526
 Fax: (720) 482-9546

CONSULTANTS OF COLORADO, INC.
 CIVIL ENGINEERING · LAND SURVEYING · LAND PLANNING