

# Location Drawing

Nearest:  
 Building: 913' southeast  
 Above Ground Utility: 608' south  
 Public Road: 3,273' south  
 Property Line: 519' west  
 Railroad: 6,160' west

Existing Well Data:

Davis 12-9  
 Latitude: N 40.15419°  
 Longitude: W 104.78991°  
 FNL: 2059'  
 FWL: 497'  
 EL: 4879'  
 PDOP: 1.5

Existing Well Data:


Davis 0-4-9  
 Latitude: N 40.15432°  
 Longitude: W 104.78987°  
 FNL: 2012'  
 FWL: 508'  
 EL: 4882'  
 PDOP: 1.5

Existing Well Data:

Davis 2-4-9  
 Latitude: N 40.15432°  
 Longitude: W 104.78983°  
 FNL: 2012'  
 FWL: 519'  
 EL: 4882'  
 PDOP: 1.2

Existing Well Data:

Davis 4-2-9  
 Latitude: N 40.15432°  
 Longitude: W 104.78979°  
 FNL: 2012'  
 FWL: 528'  
 EL: 4882'  
 PDOP: 1.5

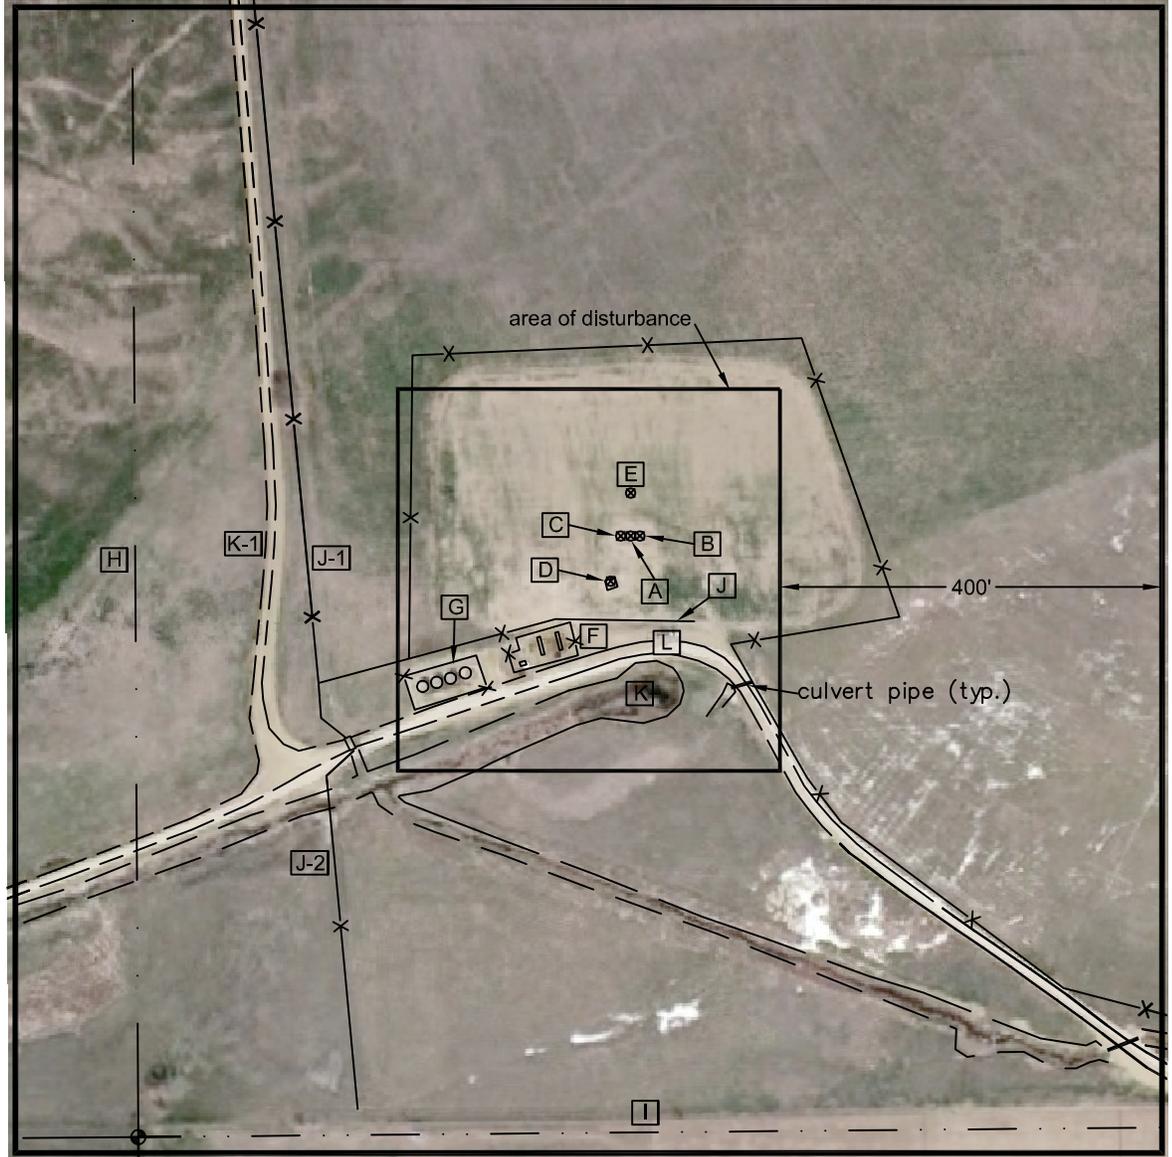

**Distances listed below are measured from the existing Davis 2-4-9**

- [A] existing Davis 2-4-9
- [B] existing Davis 4-2-9, 10' east
- [C] existing Davis 0-4-9, 10' west
- [D] existing Davis 12-9, 52' southwest
- [E] proposed Davis 2A-9H
- [F] fenced in separators & meter hut 111' southwest
- [G] fenced in tanks 204' southwest
- [H] property line 519' west
- [I] property line 625' south
- [J] fenced 88' south
- [J-1] fenced 340' southwest
- [J-2] fenced 405' southwest
- [K] ditch 133' south
- [K-1] ditch 346' southwest
- [L] access 111' south
- [L-1] access 373' west

Field observations taken on 9/27/11 by operator Tom Winans.

**Davis SWNW  
Pad Location Drawing**

Improvements extending  
400' from disturbance

Township 2 North, Range 66 West,  
Section 9: SW $\frac{1}{4}$  NW $\frac{1}{4}$   
Weld County, Colorado



Scale: 1"=200'

October 25, 2011

**PLS Group, LLC**  
 109 Coronado Ct. - Building No. 7  
 Fort Collins, Colorado 80525  
 P. 970-282-3446 Fx. 970-377-6767