

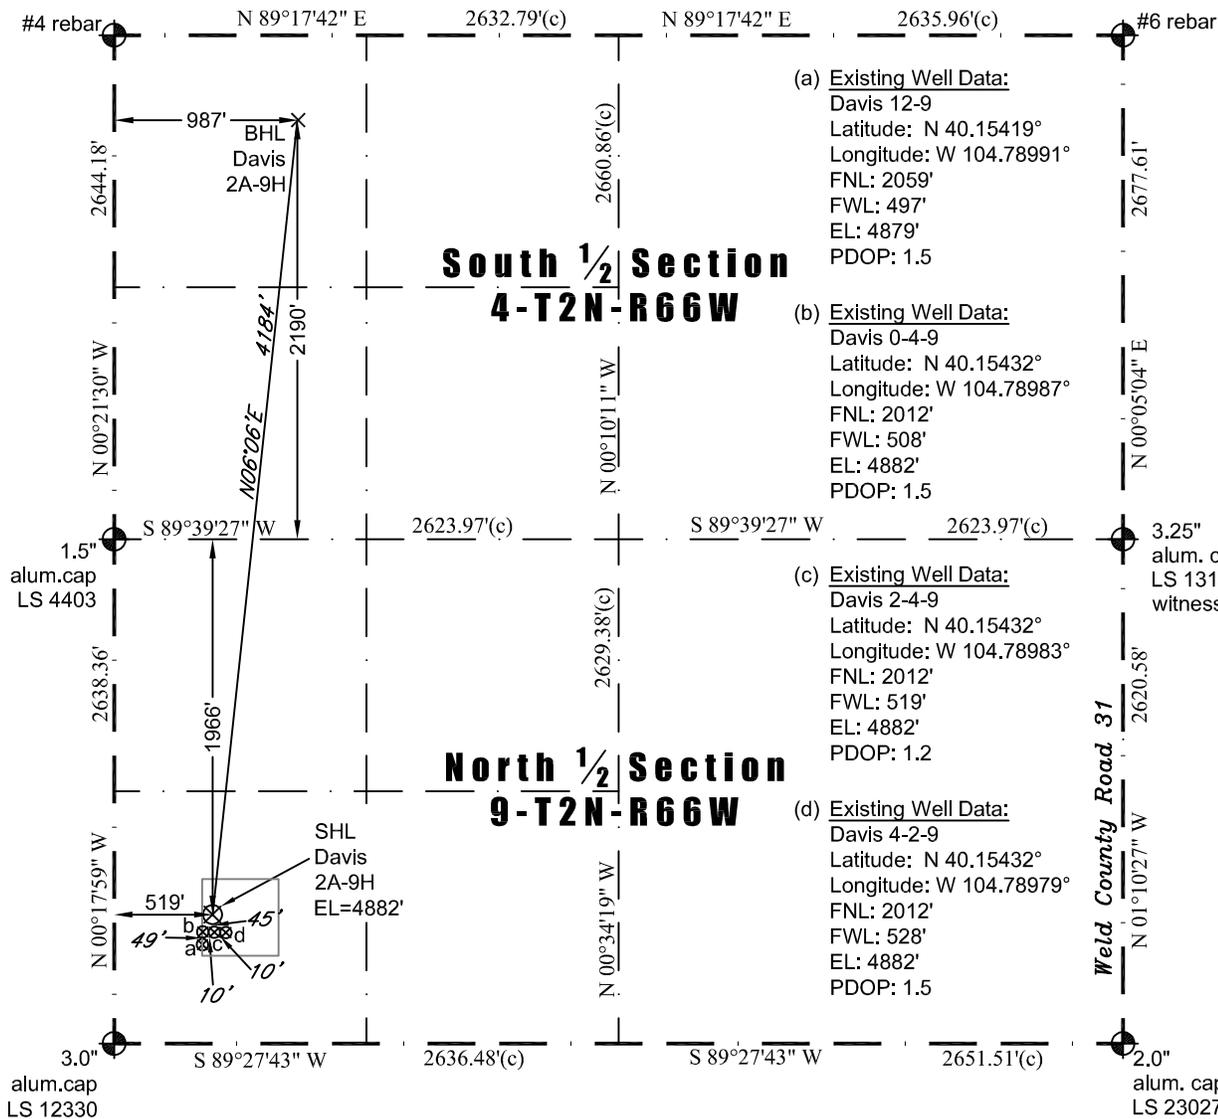


WELL LOCATION CERTIFICATE

THIS MAP DOES NOT REPRESENT A BOUNDARY SURVEY

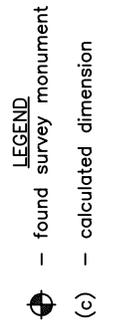

- (a) Existing Well Data:
 Davis 12-9
 Latitude: N 40.15419°
 Longitude: W 104.78991°
 FNL: 2059'
 FWL: 497'
 EL: 4879'
 PDOP: 1.5
- (b) Existing Well Data:
 Davis 0-4-9
 Latitude: N 40.15432°
 Longitude: W 104.78987°
 FNL: 2012'
 FWL: 508'
 EL: 4882'
 PDOP: 1.5
- (c) Existing Well Data:
 Davis 2-4-9
 Latitude: N 40.15432°
 Longitude: W 104.78983°
 FNL: 2012'
 FWL: 519'
 EL: 4882'
 PDOP: 1.2
- (d) Existing Well Data:
 Davis 4-2-9
 Latitude: N 40.15432°
 Longitude: W 104.78979°
 FNL: 2012'
 FWL: 528'
 EL: 4882'
 PDOP: 1.5

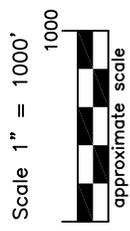

In accordance with a request from Jay Knutson of EnCana Oil & Gas (USA) Inc., PLS Group, LLC has determined the location of the **Davis 2A-9H** well site to be SHL: 1966' FNL and 519' FWL, (BHL 2190' FSL and 987' FWL) as measured at ninety (90) degrees from the section lines of Section 9, & Section 4, Township 2 North, Range 66 West, 6th Principal Meridian, Weld County, CO.

Proposed Surface Hole Data:
 Latitude: N 40.15444° (BHL 40.16585°)
 Longitude: W 104.78983° (BHL 104.78812°)
 PDOP: 1.4

Nearest:
 Building 2714' southeast Above Ground Utility 653' south
 Public Road 3318' south Railroad 6160' west
 Property Line 519' west Window Well: SHL is 61' inside
 Existing Well: Davis 2-4-9, 45' south

- Notes:
- 1) Bearings and distances based on NAD 83 Colorado North State Plane Coordinates using RTK GPS observations taken 9/27/11 by operator Tom Winans.
 - 2) Conversion factor to ground (1.000275398).
 - 3) Elevations based on NAVD 88 GPS heights and Geoid 2003 corrections.
 - 4) See Location Drawing for visible improvements within 400 feet.
 - 5) The location falls on a cultivated field.

NOTICE: According to Colorado law you must commence any legal action based upon any defect in this W.L.C. within three years after you first discover such defect. In no event may any action based upon any defect in this W.L.C. be commenced more than ten years from this said date of the certification shown hereon.

I hereby certify that this Well Location Certificate was prepared by me or under my direct supervision on 10/10/2011 for and on behalf of EnCana Oil & Gas (USA) Inc. That it is not a Land Survey Plat or an Improvement Survey Plat and that it is not to be relied upon for establishment of fences, buildings, or other future improvement lines.



John Robert McGehee LS#38219
 Well: Davis 2A-9H WLC