




# **DRILLING COMPANY, INC.** **WICHITA, KANSAS**

## **Wellbore Diagram**

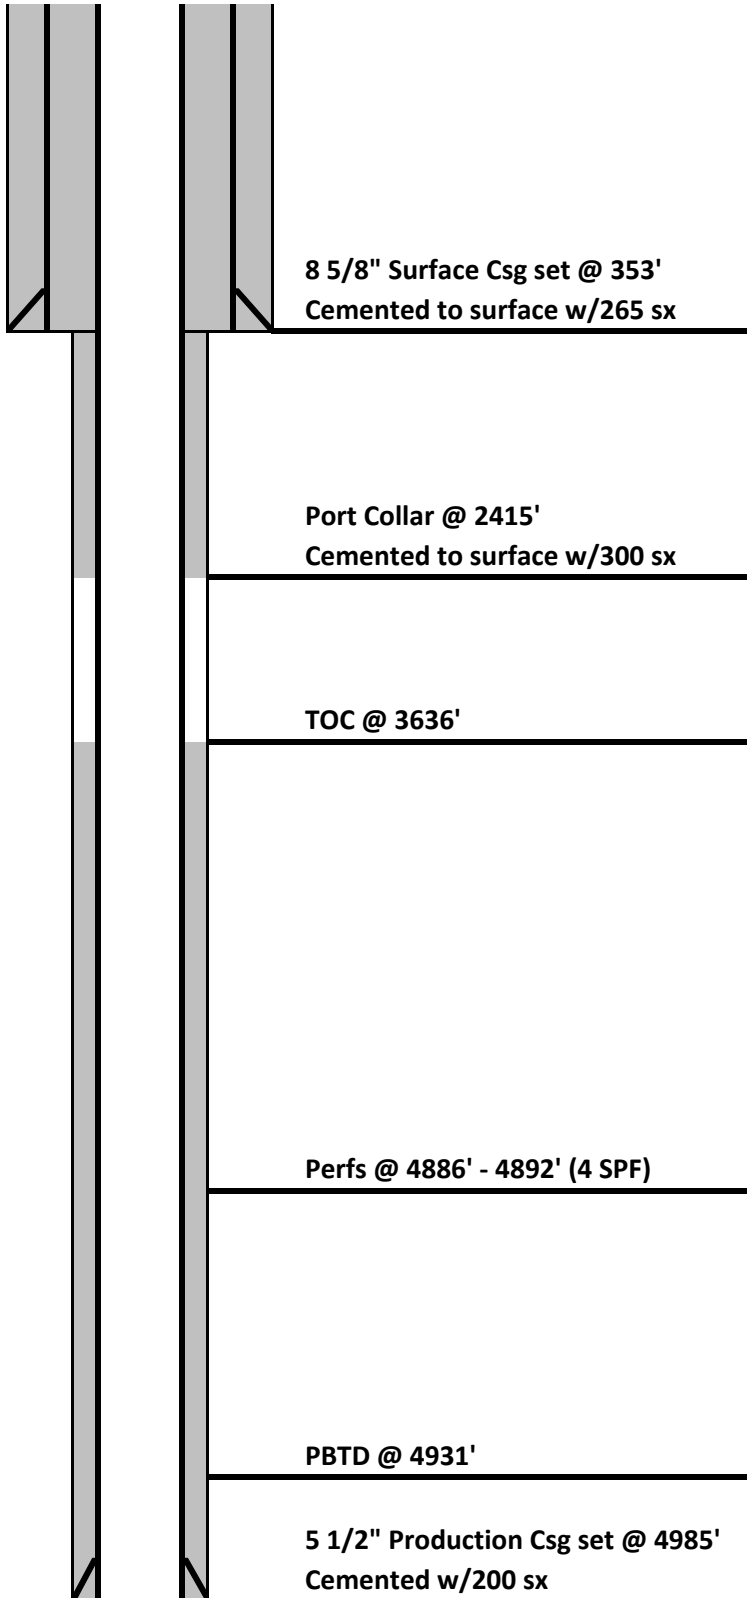

|            |                      |
|------------|----------------------|
| Date:      | 11/8/2011            |
| Well Name: | APC-Tallman #3-3     |
| Location:  | 1980' FSL & 660' FEL |
|            | NESE 3-18S-45W       |
| County:    | Kiowa                |
| State:     | Colorado             |
| API:       | 05-061-06864-00-00   |
| Spud Date: | 9/20/2011            |

|                 |                      |
|-----------------|----------------------|
| Hole Size       | 12 1/4"              |
| Surface Casing: | Set @ 353' (8 5/8")  |
| Cemented with:  | 265 sx               |
| Production Csg: | Set @ 4985' (5 1/2") |
| Cemented with:  | 200 sx               |

### **Log Tops:**

|                |      |
|----------------|------|
| Shawnee        | 3532 |
| Heebner Shale  | 3732 |
| Lansing        | 3753 |
| Marmaton       | 4136 |
| Ft. Scott      | 4216 |
| Cherokee Shale | 4273 |
| Atoka          | 4406 |
| Morrow Shale   | 4534 |
| Keyes          | 4674 |
| Mississippian  | 4724 |
| RTD            | 4990 |
| LTD            | 4993 |