


WELL LOCATION CERTIFICATE

THIS MAP DOES NOT REPRESENT A BOUNDARY SURVEY

SECTION: 22
TOWNSHIP: 3N
RANGE: 65W

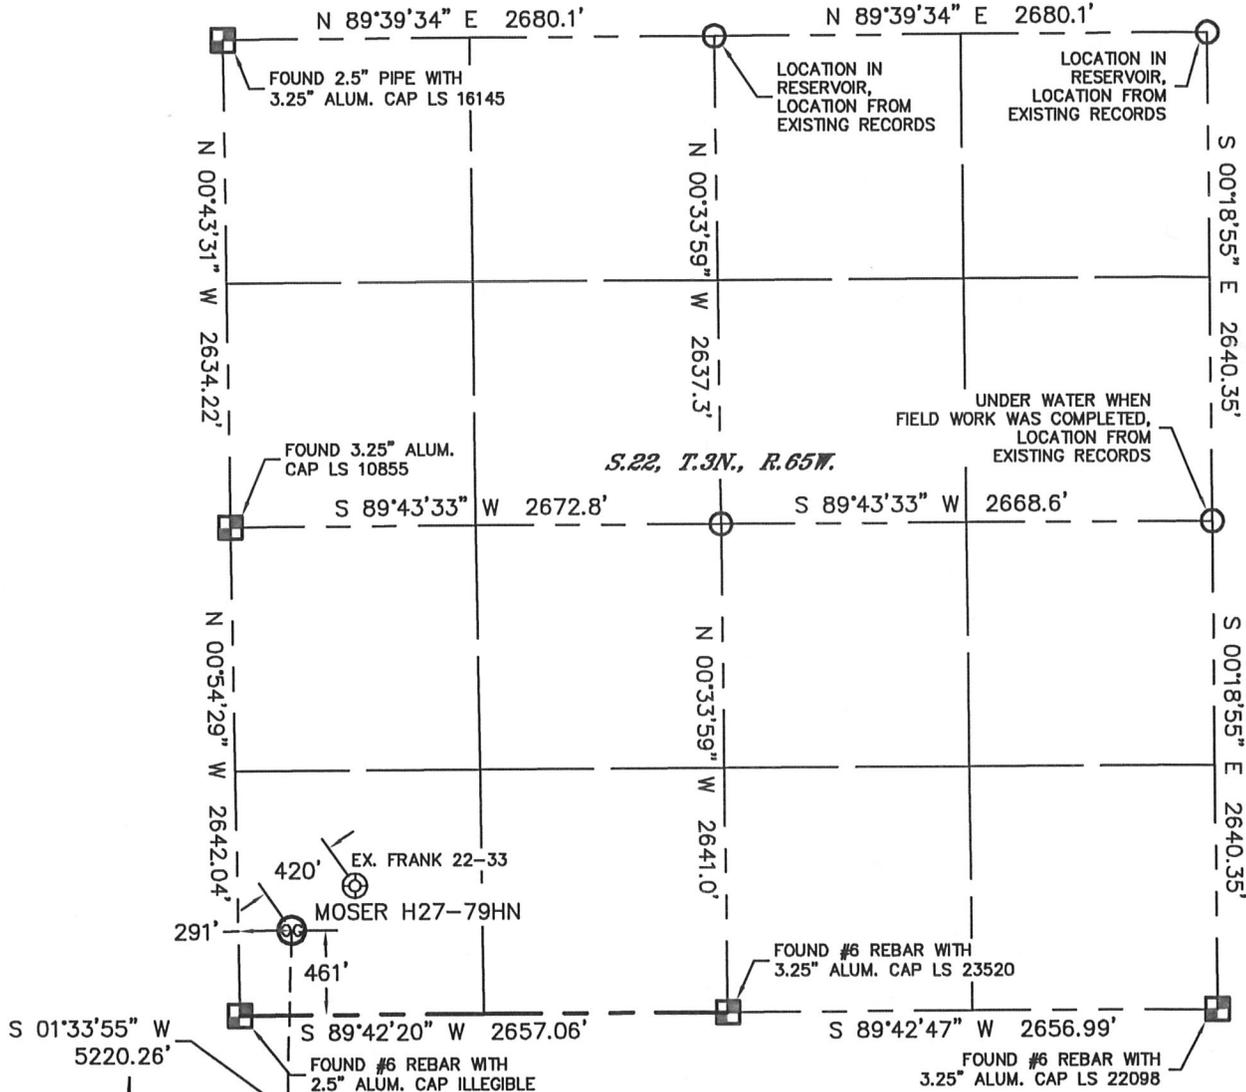

In accordance with a request from Scott Lewis with Noble Energy Inc. Lat40°, Inc. has determined the surface location of the MOSEY H27-79HN to be 461' from the SOUTH line and 291' from the WEST line as measured at right angles from the section lines of Section 22, Township 3 North, Range 65 West and the bottom hole to be 535' from the SOUTH line and 75' from the WEST line as measured at right angles from the section lines of Section 27, Township 3 North, Range 65 West of the Sixth Principal Meridian, County of Weld, State of Colorado.

I hereby state that this Well Location Certificate was prepared by me, or under my direct supervision, that the fieldwork was completed on 8/17/2011, for and on behalf of Noble Energy Inc. That this is not a Land Survey Plat or an Improvement Survey Plat, and that it is not to be relied upon for establishment of fence, building, or other future improvement lines.

NOTE:

- 1) Bearings shown are Grid Bearings of the Colorado State Plane Coordinate System, North Zone, North American Datum 1983/2007. The lineal dimensions as contained herein are based upon the "U.S. Survey Foot."
- 2) Ground elevations are based on an observed GPS elevation (NAVD 1988 DATUM).
- 3) NEAREST EXISTING WELL: FRANK 22-33, 420'
- 4) IMPROVEMENTS: See LOCATION DRAWING for all visible improvements within 400' of disturbed area.
- 5) SURFACE USE: PIVOT CORNER
- 6) INSTRUMENT OPERATOR: BRIAN BRINKMAN

SURFACE LOCATION
LATITUDE: 40.20495°N
LONGITUDE: 104.65824°W
PDOP: 1.4
ELEV: 4813'
1/4, 1/4: SW1/4SW1/4
NEAREST PROPERTY LINE: 291' W

BOTTOM HOLE
LATITUDE: 40.19064°N
LONGITUDE: 104.65892°W

NOTE

According to Colorado law, you must commence any legal action based upon any defect in this W.L.C. within three years after you discover such defect. In no event, may any action based upon any defect in this survey be commenced more than ten years after the date of the certificate shown hereon. (13-80-105 C.R.S.)

LEGEND

-  = ALIQUOT MONUMENT AS DESCRIBED
-  = CALCULATED POSITION

SHEET 1 OF 2

Brian T. Brinkman—On behalf of Lat40° Inc.
Colorado Licensed Professional
Land Surveyor No. 38175



PROJECT#: 2011203



WELL LOCATION CERTIFICATE

THIS MAP DOES NOT REPRESENT A BOUNDARY SURVEY

SECTION: 22
TOWNSHIP: 3N
RANGE: 65W

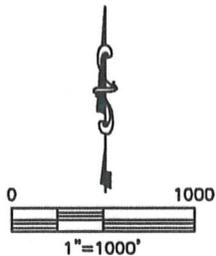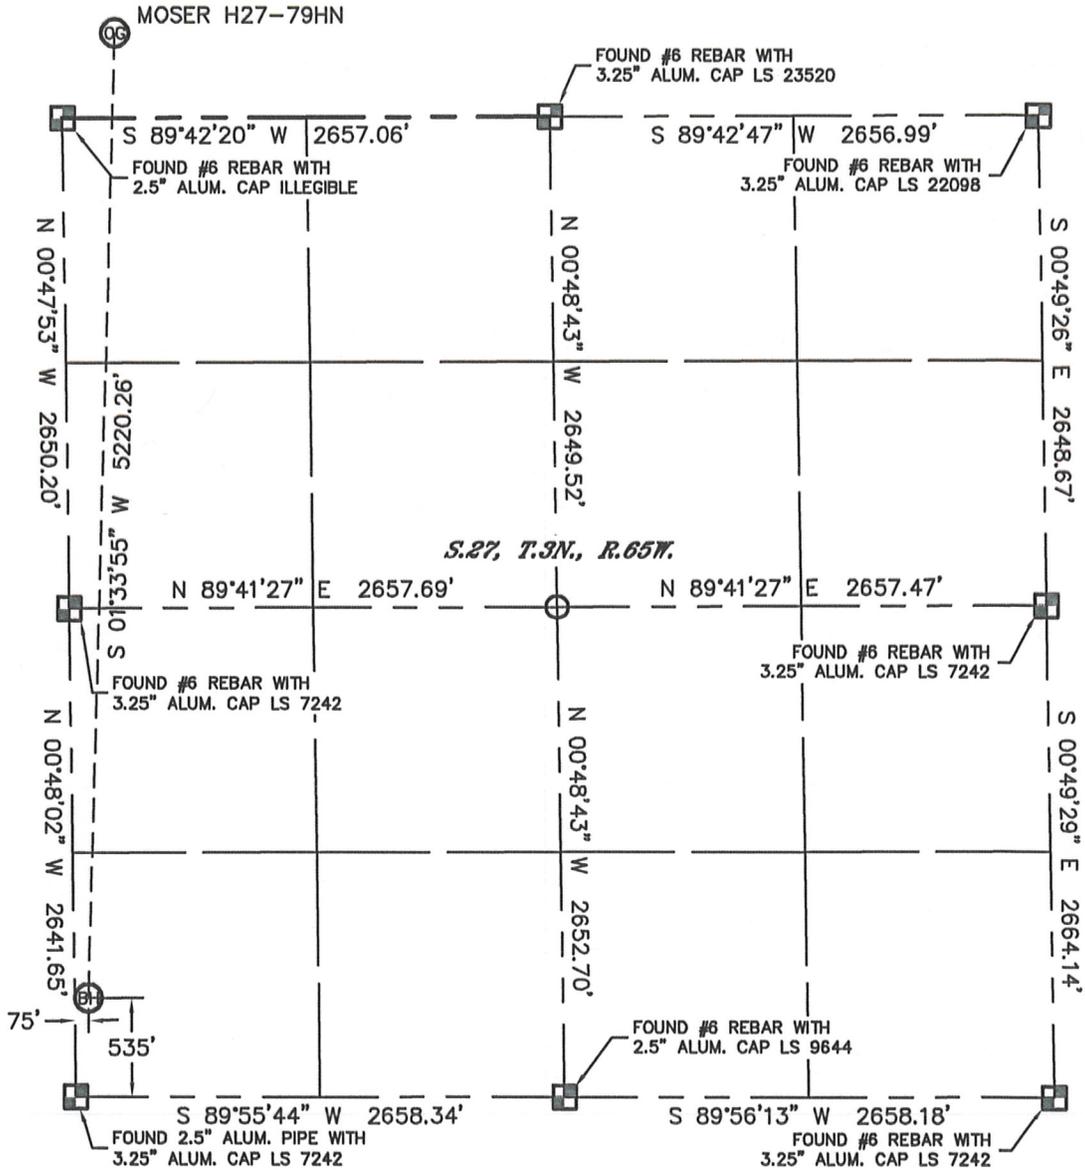

NOTE
According to Colorado law, you must commence any legal action based upon any defect in this W.L.C. within three years after you discover such defect. In no event, may any action based upon any defect in this survey be commenced more than ten years after the date of the certificate shown hereon. (13-80-105 C.R.S.)

LEGEND
 = ALIQUOT MONUMENT AS DESCRIBED
 = CALCULATED POSITION



SHEET 2 OF 2


Brian T. Brinkman—On behalf of Lat40°, Inc.
Colorado Licensed Professional
Land Surveyor No. 38175

PROJECT#: 2011203

SITE SKETCH

MOSER H27-79HN

SECTION: 22
TOWNSHIP: 3N
RANGE: 65W

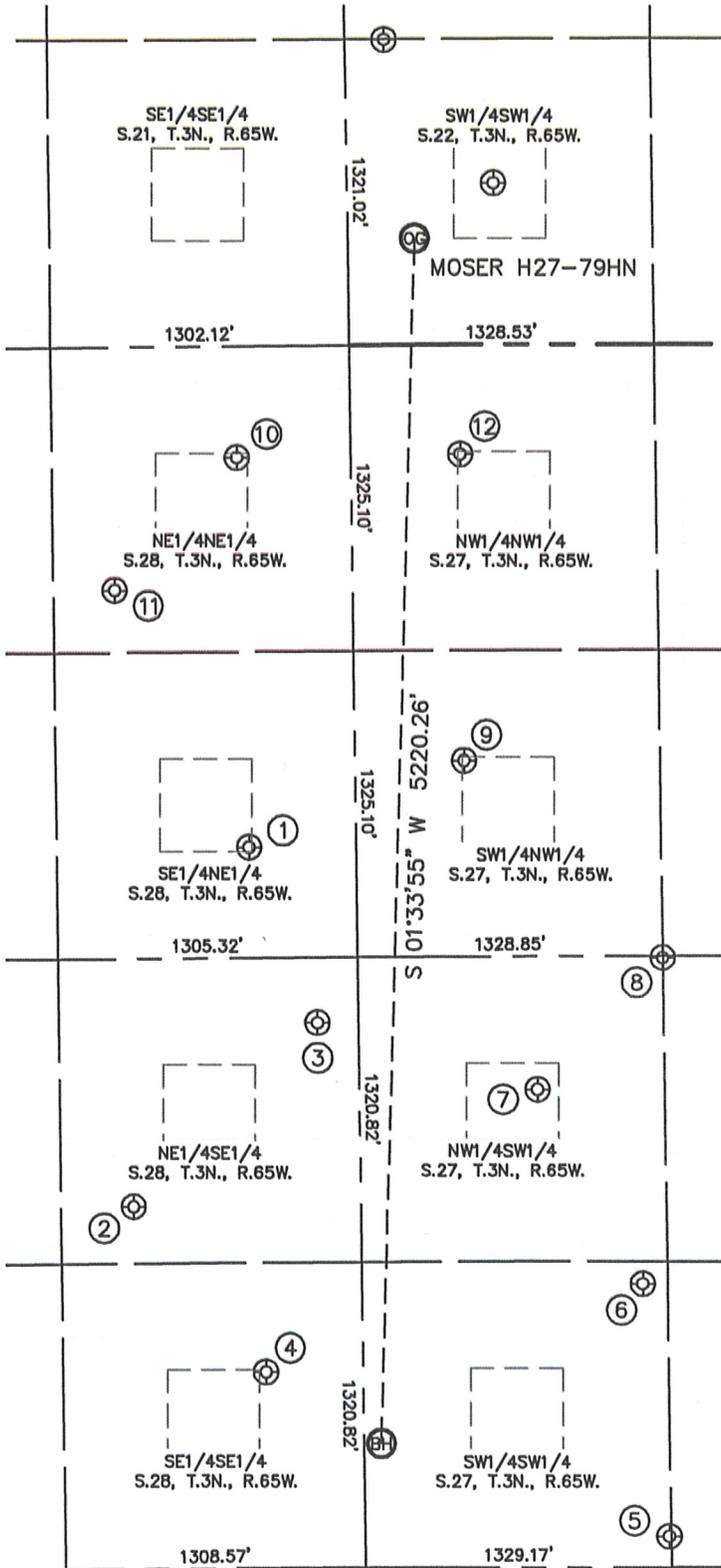

- | | | |
|--|--|--|
| <p>①
MOSER 28-B
SE1/4NE1/4
2169' FNL
466' FEL
LAT-40.19774°N
LONG-104.66090°W
PDOP: 1.6
ELEV: 4824'</p> | <p>②
CANNON 3-28 1
NE1/4SE1/4
1570' FSL
990' FEL
LAT-40.19348°N
LONG-104.66275°W
PDOP: 1.3
ELEV: 4829'</p> | <p>③
MOSER H27-32
NE1/4SE1/4
2360' FSL
179' FEL
LAT-40.19565°N
LONG-104.65986°W
PDOP: 1.2
ELEV: 4825'</p> |
| <p>④
CANNON LAND 28-16J
SE1/4SE1/4
849' FSL
422' FEL
LAT-40.19150°N
LONG-104.66071°W
PDOP: 2.0
ELEV: 4831'</p> | <p>⑤
RITCHEY H34-29
SW1/4SW1/4
135' FSL
1320' FWL
LAT-40.18951°N
LONG-104.65446°W
PDOP: 1.2
ELEV: 4834'</p> | <p>⑥
RITCHEY H27-25
SW1/4SW1/4
1228' FSL
1221' FWL
LAT-40.19251°N
LONG-104.65483°W
PDOP: 1.7
ELEV: 4822'</p> |
| <p>⑦
RITCHEY H27-12
NW1/4SW1/4
2069' FSL
775' FWL
LAT-40.19483°N
LONG-104.65644°W
PDOP: 2.5
ELEV: 4821'</p> | <p>⑧
RITCHEY H27-20
NW1/4SW1/4
2640' FSL
1328' FWL
LAT-40.19638°N
LONG-104.65447°W
PDOP: 2.3
ELEV: 4819'</p> | <p>⑨
RITCHEY H27-5
SW1/4NW1/4
1801' FNL
476' FWL
LAT-40.19874°N
LONG-104.65754°W
PDOP: 1.7
ELEV: 4817'</p> |
| <p>⑩
MOSER H28-1
NE1/4NE1/4
481' FNL
497' FEL
LAT-40.20237°N
LONG-104.66104°W
PDOP: 1.3
ELEV: 4814'</p> | <p>⑪
MOSER 41-28
NE1/4NE1/4
1052' FNL
1036' FEL
LAT-40.20080°N
LONG-104.66296°W
PDOP: 1.9
ELEV: 4824'</p> | <p>⑫
RITCHEY H27-4
NW1/4NW1/4
473' FNL
477' FWL
LAT-40.20239°N
LONG-104.65755°W
PDOP: 3.6
ELEV: 4814'</p> |

