


ENTEK ENERGY GRB LLC



Well Name:	Battle Mountain Federal 14-10L
AFE:	RDC1-033
DATE OF WBD:	11/01/11

KB: 18'
GL: 6676'

37.1 bbls/1000' with tbg in hole
39.5 bbls/1000' without tbg in hole

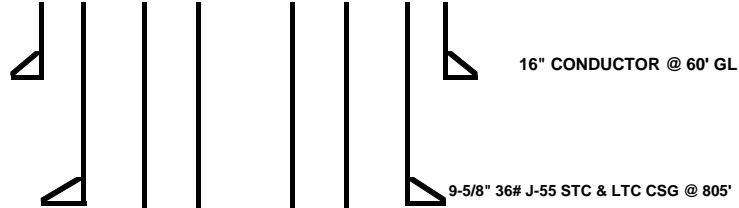

FRAC INTERVAL WITH:
556 BBLs TREATED FLUID
5000# 100 MESH SAND
19,880# 20/40 SAND

6592-99' 21 HOLES
6643-49' 17 HOLES
(1 MIS-FIRE)
6662-68' 18 HOLES
CBP @ 6720'

2-7/8" TBG @ 6571'
SEAT NIPPLE AND NOTCHED COLLAR ON BOTTOM

3 SPF 120 DEG PHA
3 SPF 120 DEG PHA
3 SPF 120 DEG PHA

WOLF MOUNTIAN BENCH

FRAC SCREENED OUT

6918-24' 18 HOLES
6930-37' 21 HOLES
6940-48' 24 HOLES
CBP @ 7115'

3 SPF 120 DEG PHA
3 SPF 120 DEG PHA
3 SPF 120 DEG PHA

BASAL NIOBRARA BENCH

FRAC INTERVAL WITH:
1216 BBLs TREATED FLUID
2500# 100 MESH SAND
48,000# 20/40 SAND

7318-24' 18 HOLES
7339-47' 21 HOLES

3 SPF 120 DEG PHA
3 SPF 120 DEG PHA

FRONTIER

FLOAT COLLAR 7440'
FLOAT SHOE 7487'
TD: 7500'

7" 23# P-110 LTC CASING @ 7487'