


MULTI-WELL PLAN

GRIGSBY AC19-62HN, PC AC30-73HN

THIS MAP DOES NOT REPRESENT A BOUNDARY SURVEY

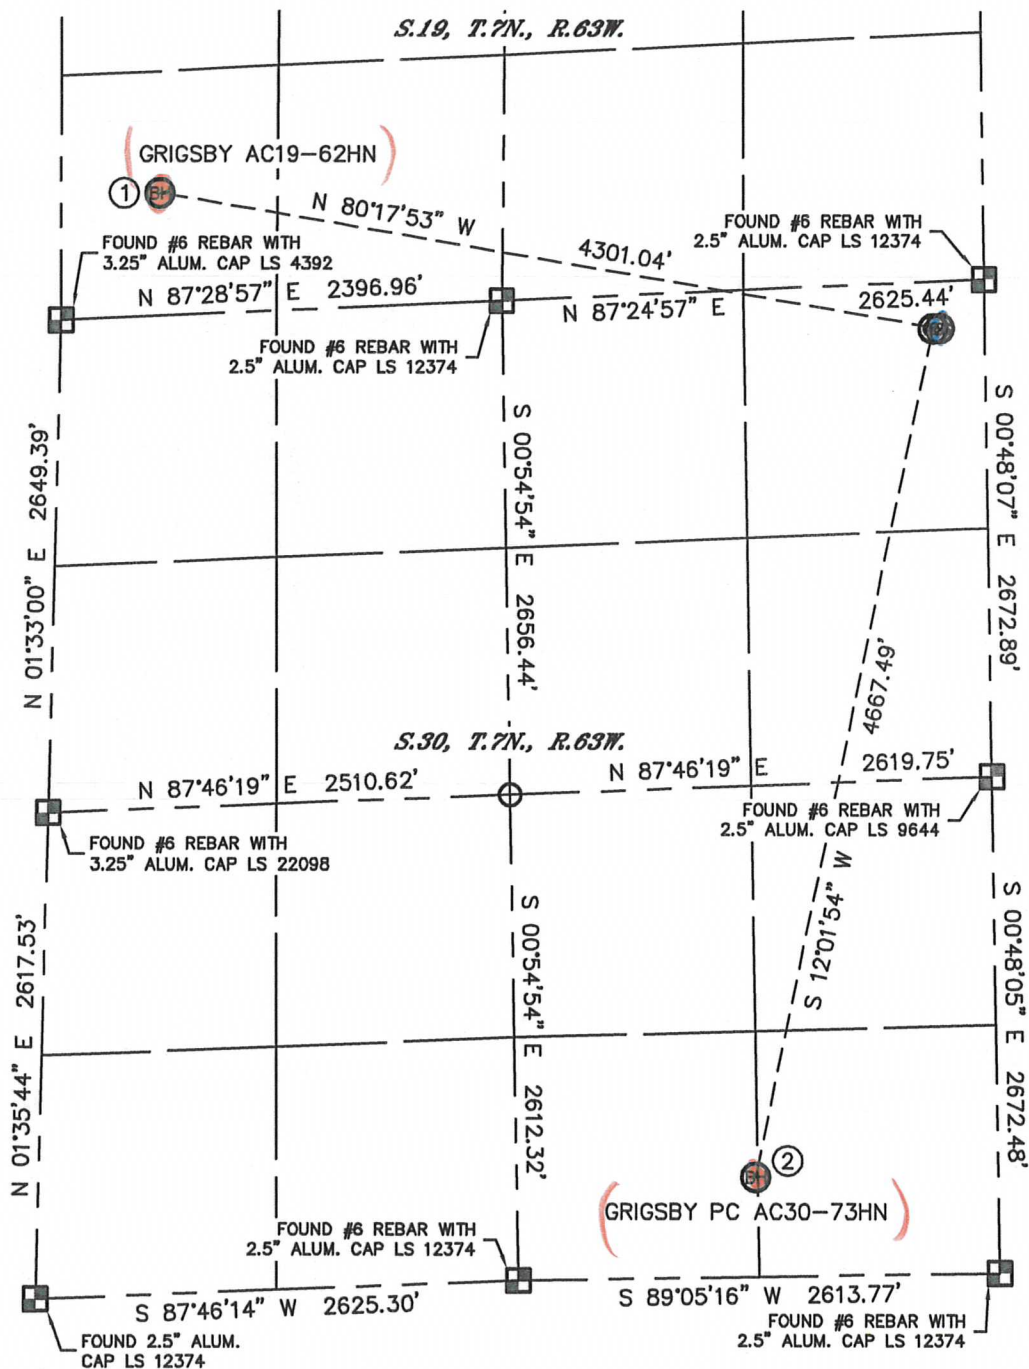

SECTION: 30
TOWNSHIP: 7N
RANGE: 63W




①
-BOTTOM HOLE-
GRIGSBY AC19-62HN
660' FSL
535' FWL
LAT-40.55359°N
LONG-104.48650°W

②
-BOTTOM HOLE-
GRIGSBY PC AC30-73HN
535' FSL
1320' FEL
LAT-40.53897°N
LONG-104.47510°W

LEGEND

-  = ALIQUOT MONUMENT AS DESCRIBED
-  = CALCULATED POSITION

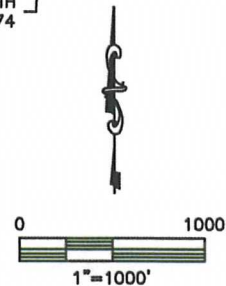

Lat40°, Inc. 1635 Foxtrail Drive, Suite 325 Loveland, CO 970-776-3321

MULTI-WELL PLAN

GRIGSBY AC19-62HN, PC AC30-73HN

SECTION: 30
TOWNSHIP: 7N
RANGE: 63W

