

ENTEK ENERGY GRB LLC

SD FEDERAL 24-9 DL - Original Hole

NESE Section 24 T12N-R89W

API: 05-081-07624-00


Spud: 07-Aug-11

Comp: TD Reached 8/23/2011

PB Date 9/3/2011

KB: 7050

GL: 7068

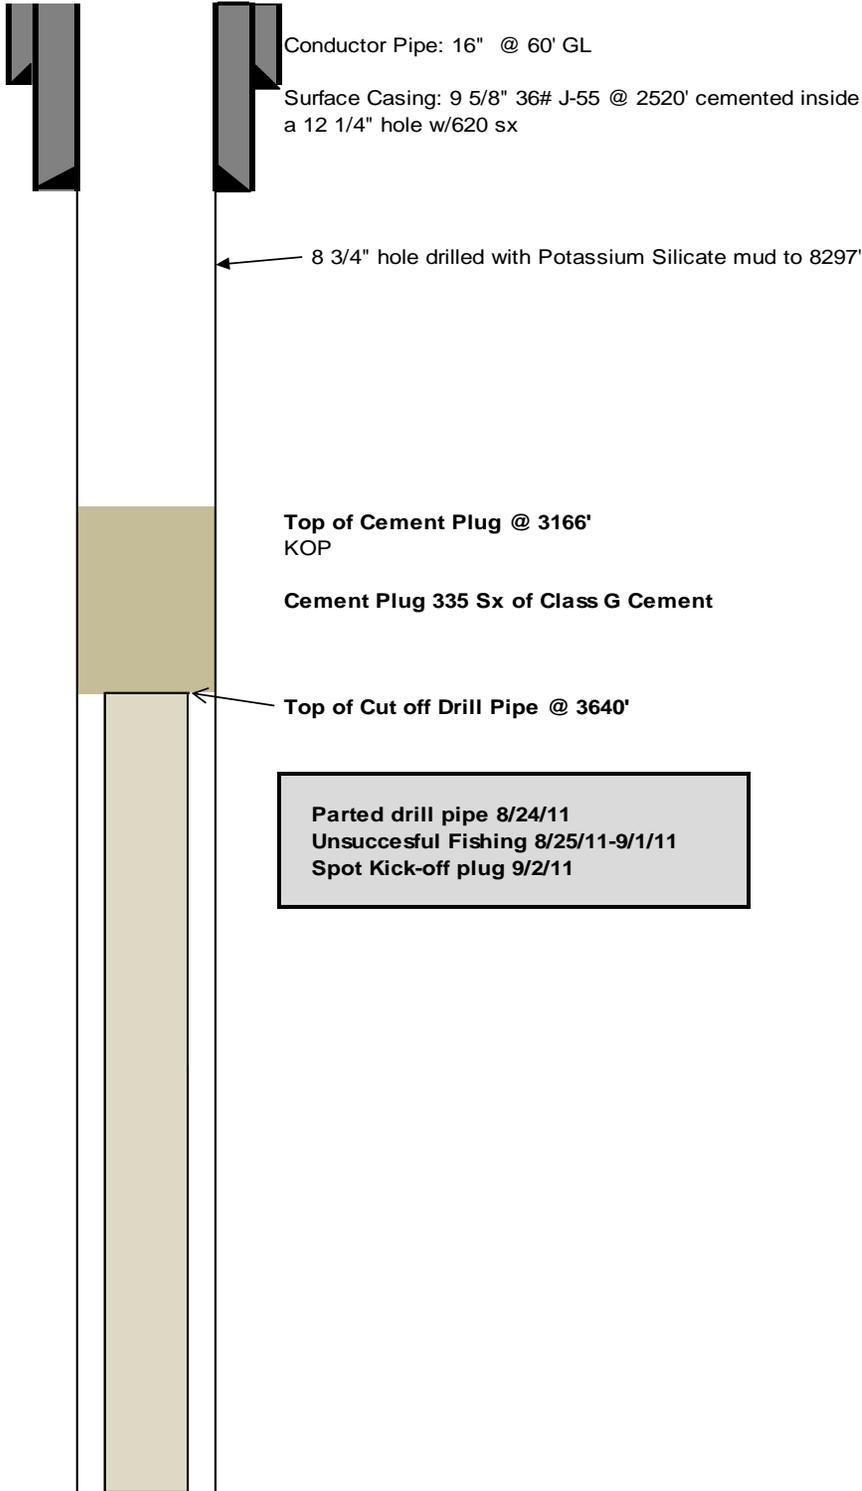

Parted drill pipe 8/24/11
Unsuccessful Fishing 8/25/11-9/1/11
Spot Kick-off plug 9/2/11

TMD 8297'
Driller

TVD 8102'