




**DRILLING COMPANY, INC.**  
**WICHITA, KANSAS**

**Wellbore Diagram**

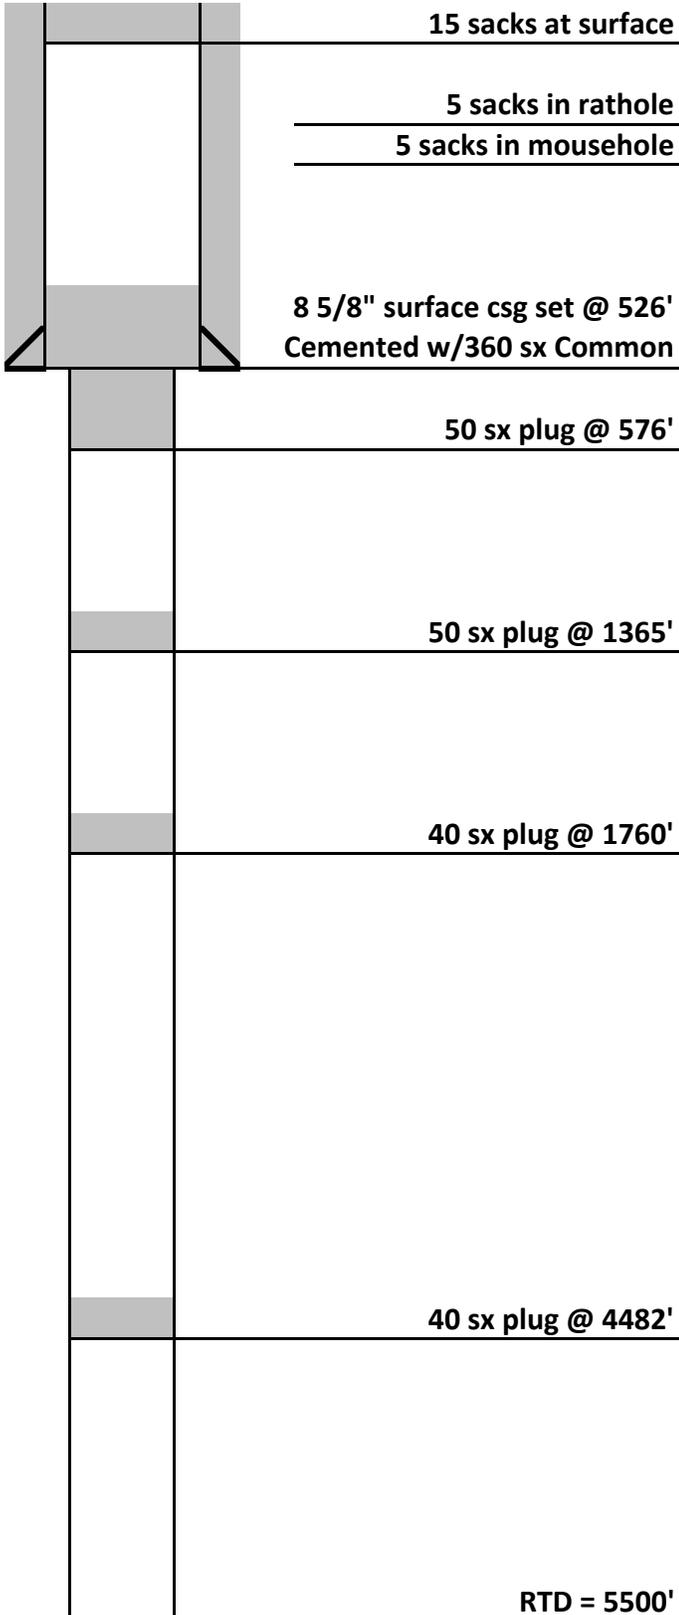

Date:	11/29/2011
Well Name:	APC-Medford State Unit #1-9
Location:	398' FSL & 1083' FEL
	SE/4 SE/4 9-16S-46W
County:	Cheyenne
State:	Colorado
API:	05-017-07706-00
Surface Casing:	8 5/8" set @ 526'
Cemented with:	360 sx Common
Total Depth:	5500'
Spud Date:	6/15/2011
P&A Date:	11/8/2011

<u>Log Tops:</u>	
Shawnee	3833'
Heebner Shale	4042'
Lansing	4090'
Ft. Scott	4553'
Cherokee Shale	4624'
Atoka	4790'
Morrow Shale	4951'
Keyes Limestone	5133'
Mississippian	5154'
LTD	5498'
RTD	5500'