


IMPROVEMENTS WITHIN 400' OF THE WELL SITE INCLUDE: A GAS PIPE LINE & ROAD PASSES 251 FEET TO THE NORTHWEST. A TANK BATTERY IS 74' WEST, SEPERATOR IS 92' SOUTHWEST.

BHL ANTELOPE F-20
 LAT. = 40.39211° N
 LONG = -104.35205° W
 50.0' FNL, 1250.0' FWL
 718.48' horizontal
 48.80361° azimuth

SHL ANTELOPE F-20
 LAT. = 40.39083° N
 LONG = -104.3401° W
 ELEV. = 4651.67'
 516.9' FNL, 712.6' FWL
 PDOP = 3.803

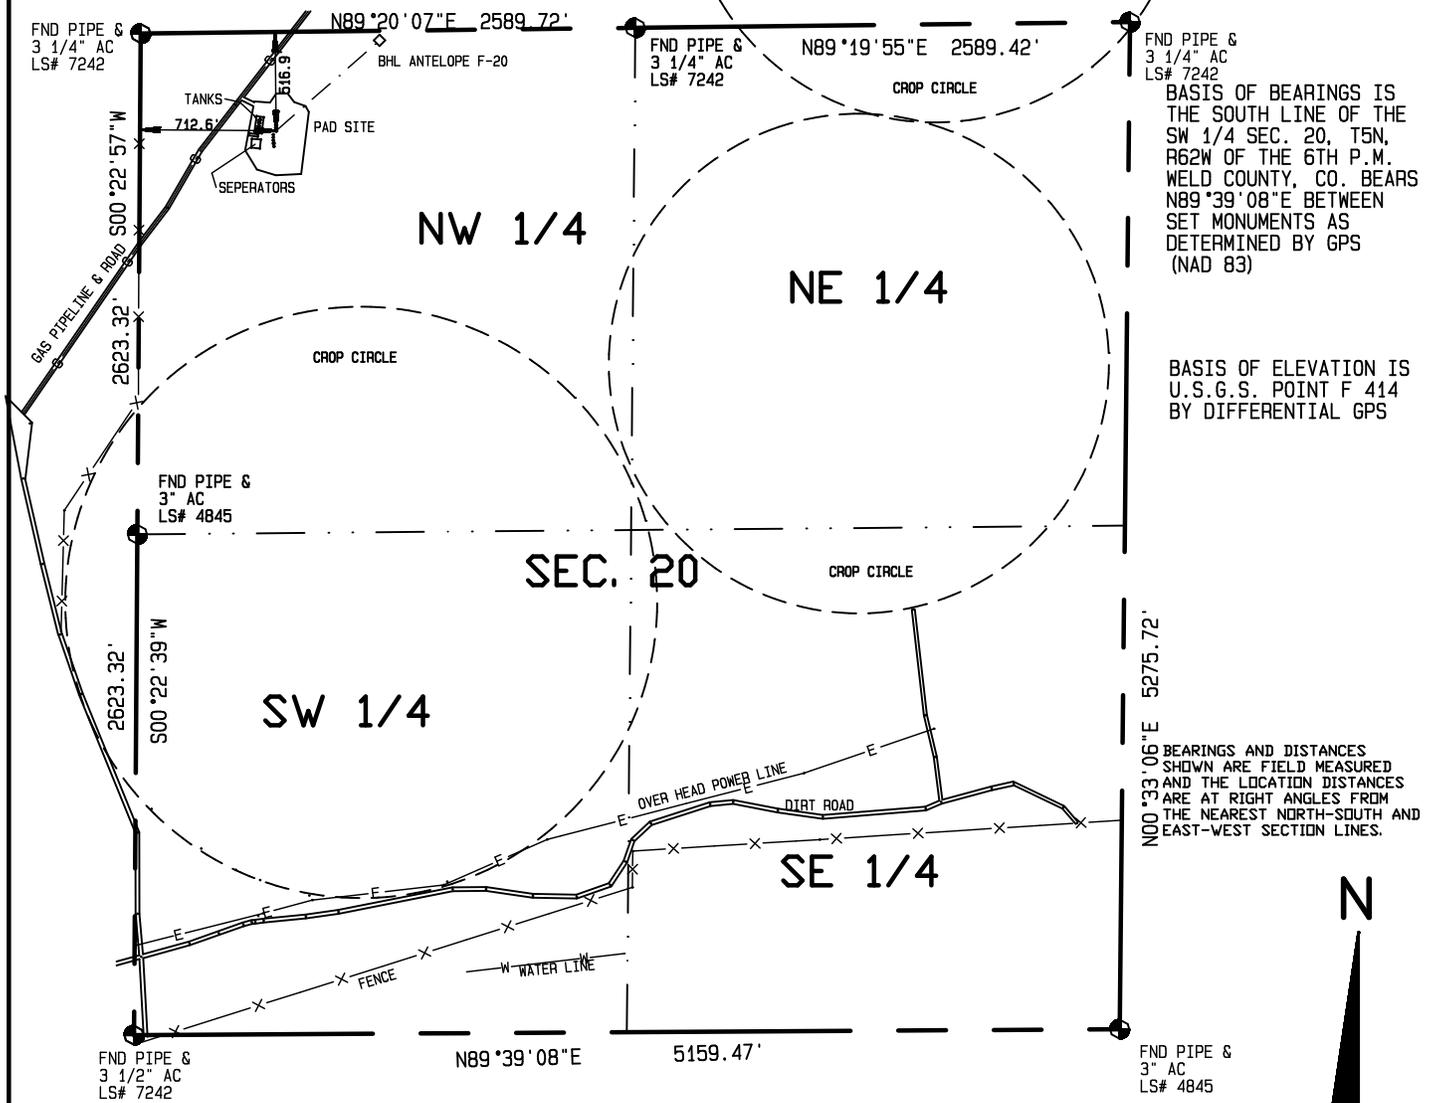

BASIS OF BEARINGS IS THE SOUTH LINE OF THE SW 1/4 SEC. 20, T5N, R62W OF THE 6TH P.M. WELD COUNTY, CO. BEARS N89°39'08"E BETWEEN SET MONUMENTS AS DETERMINED BY GPS (NAD 83)

BASIS OF ELEVATION IS U.S.G.S. POINT F 414 BY DIFFERENTIAL GPS


BEARINGS AND DISTANCES SHOWN ARE FIELD MEASURED AND THE LOCATION DISTANCES ARE AT RIGHT ANGLES FROM THE NEAREST NORTH-SOUTH AND EAST-WEST SECTION LINES.

I HEREBY CERTIFY THAT THIS PLAT IS AN ACCURATE REPRESENTATION OF A CORRECT SURVEY SHOWING THE LOCATION OF SAID WELLSITE:

Dan Griggs PLS# 38018

CONTRACT SURVEYORS, LTD.
 COMPLETE SURVEYING AND GLOBAL POSITIONING

2133 SOUTH BELLAIRE STREET #14
 DENVER COLORADO 80222
 (303) 756-3695

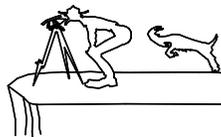

MULTIPLE WELL PLAN
 PAGE 4

CSL# 11104-63

DATE OF FIELD WORK:

8 NOVEMBER 2011

DATE OF DRAWING:

1 DECEMBER 2011

ANTELOPE F-20

NW 1/4, NW 1/4 SEC. 20, T5N, R62W

BONANAZA CREEK ENERGY OPERATING COMPANY, LLC

WELD COUNTY, COLORADO