


PLS Group, LLC  
 109 Coronado Ct. - Bldg. 7  
 Fort Collins, Colorado 80525  
 P. 970-282-3446 Fx. 970-377-6767

# WELL LOCATION CERTIFICATE

THIS MAP DOES NOT REPRESENT A BOUNDARY SURVEY

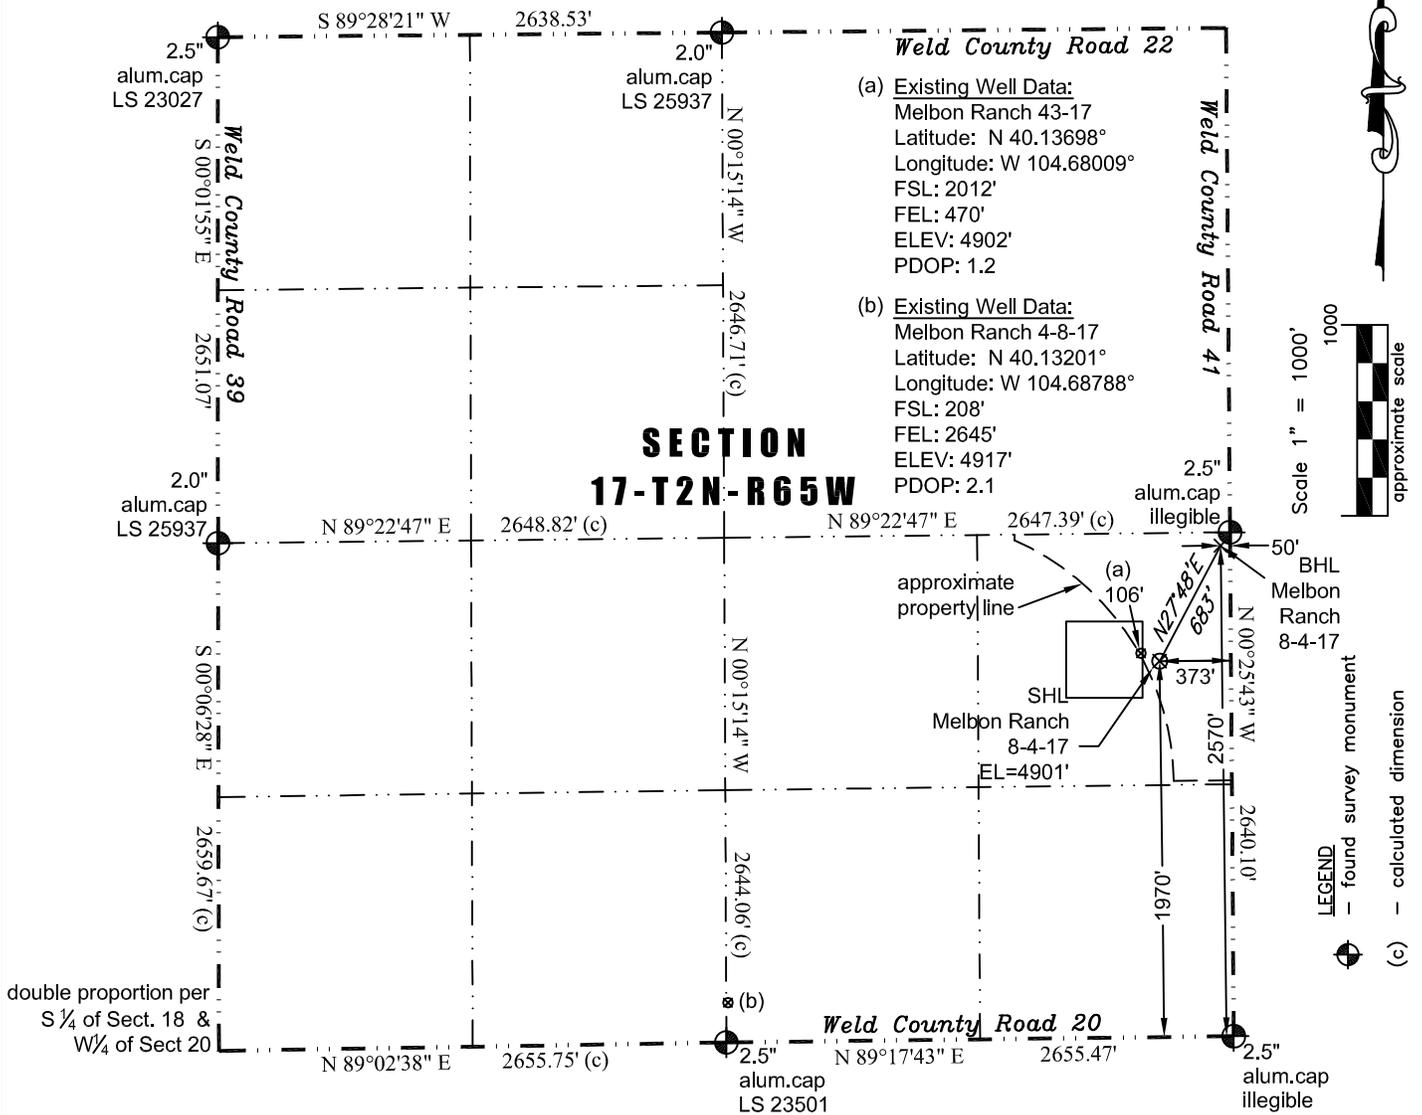

In accordance with a request from Jay Knutson of EnCana Oil & Gas (USA) Inc., PLS Group, LLC has determined the location of the **Melbon Ranch 8-4-17** well site to be SHL: 1970' FSL and 373' FEL, (BHL 2570' FSL and 50' FEL), as measured at ninety (90) degrees from the section lines of Section 17, Township 2 North, Range 65 West of the 6th Principal Meridian, Weld County Colorado.

**Proposed Surface Hole Data:**

Latitude: N 40.13686° (BHL: 40.13851°)  
 Longitude: W 104.67975° (BHL: 104.67859°)  
 PDOP: 1.2

**Nearest:**

- |                                   |                                 |
|-----------------------------------|---------------------------------|
| Building 721' southeast           | Above Ground Utility 358' east  |
| Public Road 362' east             | Railroad 24,182' southeast      |
| Property Line 75' southwest       | Well Window: SHL is 89' outside |
| Existing Well: Melbon Ranch 43-17 | 106' northwest                  |

**Notes:**

- Bearings and distances based on NAD 83 Colorado North State Plane Coordinates using RTK GPS observations taken 10/24/11 by operator Tom Winans.
- Conversion factor to ground (1.000273817).
- Elevations based on NAVD 88 GPS heights and Geoid 2003 corrections.
- See Location Drawing for visible improvements within 400 feet of Pad Site.
- The surface use is irrigated corn field.

**NOTICE:** According to Colorado law you must commence any legal action based upon any defect in this W.L.C. within three years after you first discover such defect. In no event may any action based upon any defect in this W.L.C. be commenced more than ten years from this said date of the certification shown hereon.

I hereby certify that this Well Location Certificate was prepared by me or under my direct supervision on 10/20/11 for and on behalf of EnCana Oil & Gas (USA) Inc. This is not a Land Survey Plat or an Improvement Survey Plat and that it is not to be relied upon for establishment of lines, buildings, or other features in permanent lines.

**PROFESSIONAL LAND SURVEYOR**  
 JOHN ROBERT MCGEEHEE  
 LS#38219

John Robert McGehee LS#38219  
 Well: Melbon Ranch 8-4-17 WLC