
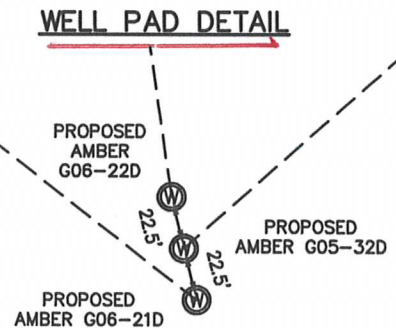
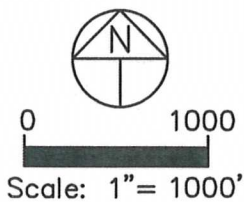


Stell Surveying Services, LLC

1102 West 19th Street P.O. BOX 2073
MULTI-WELL PLAN

Cheyenne, Wyoming 82001

SECTIONS 6
TOWNSHIP 4 NORTH
RANGE 65 WEST

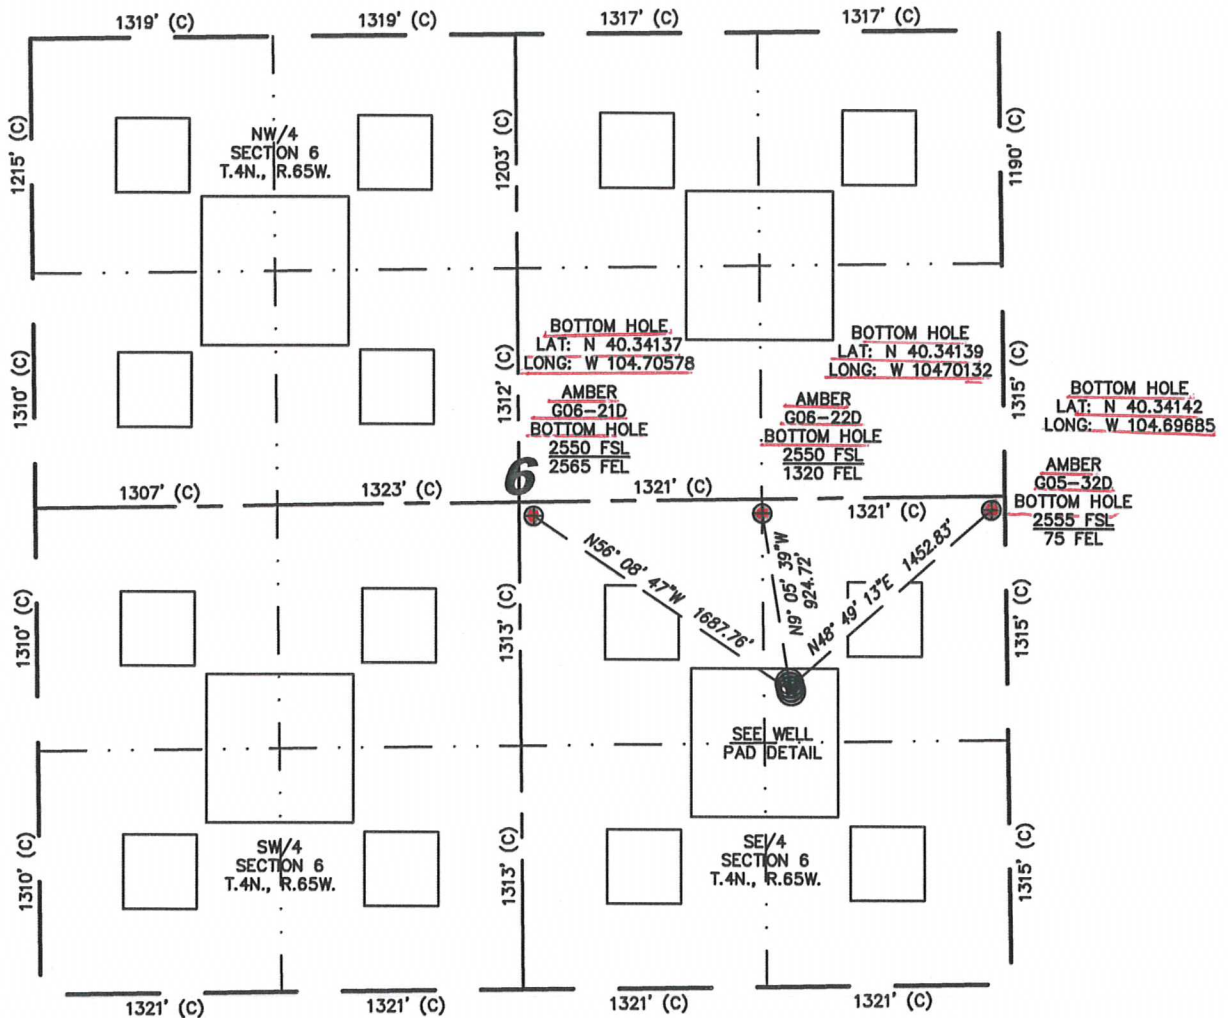

NOTES:

- 1) THIS SKETCH DOES NOT REPRESENT A BOUNDARY SURVEY.
- 2) THE DATUM FOR THE LATITUDES AND LONGITUDES ON THIS SKETCH IS NAD83.