


Well Name: HUNGENBERG 04-01

Well Config: VERTICAL - ORIGINAL HOLE, 12/12/2011 11:28:18 AM

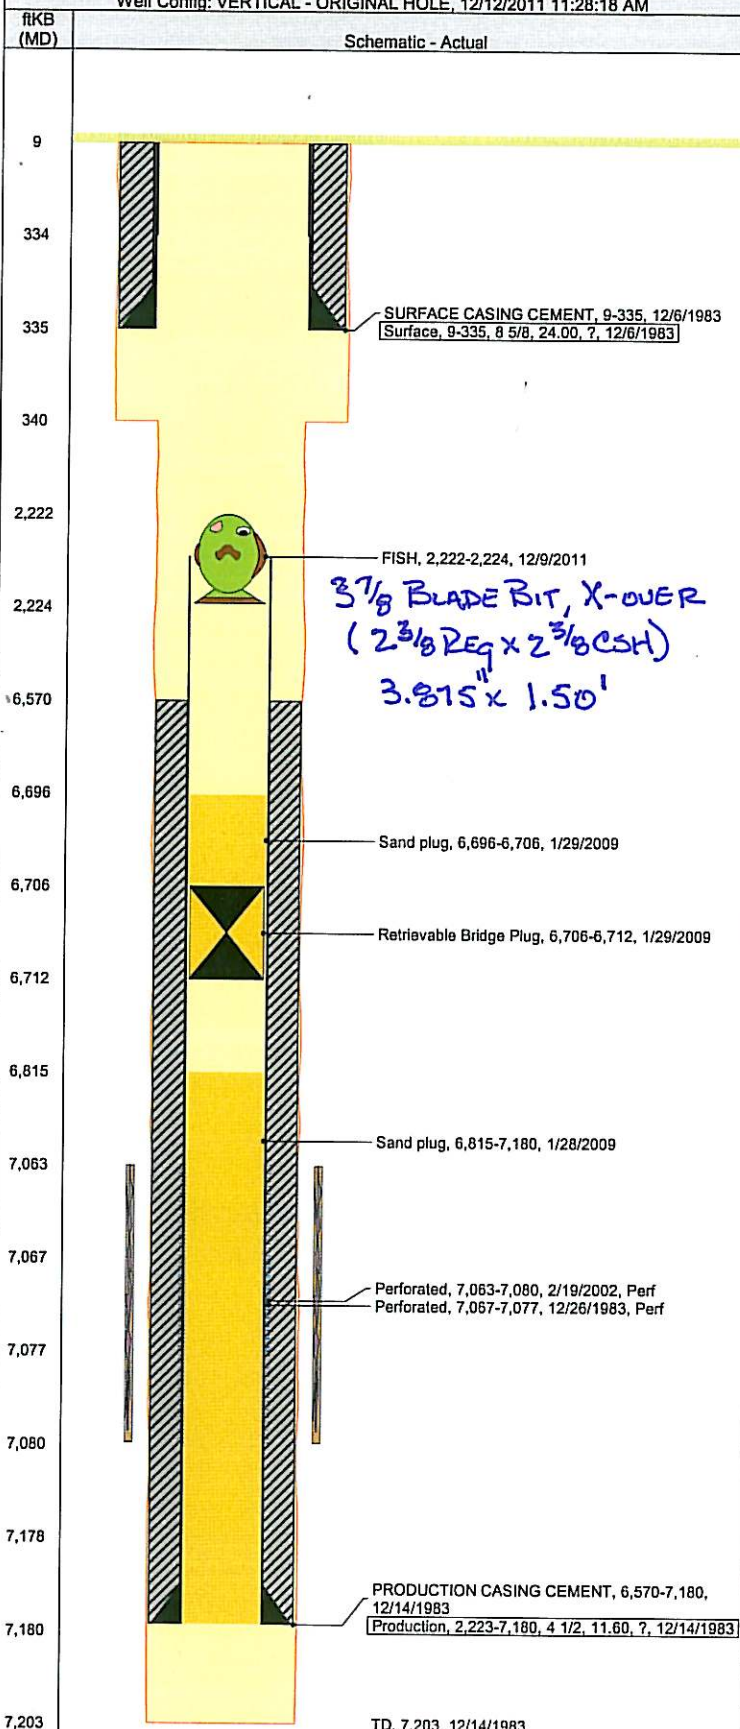

Well Header

API	Business Unit	Spud Date	Well Configuration Type
05-123-11474	WATTENBERG	12/5/1983	VERTICAL
Orig KB Elev (ft)	KB - GL / ...	Quarter Quarter	Sec/Abs
4,680.00	9	NENW	4N
Twn/Sur...	Range	P & A Date	
65W			

Comment

Directions To Well

RD 50 & RD 43. WEST 6/10. SOUTH 25' TO BATT. EAST 1/10. SOUTH 2/10 INTO.

Bottom Hole Location

North-South Distance (ft)	From N or S Line	East-West Distance (ft)	From E or W Line
---------------------------	------------------	-------------------------	------------------

PBTds

Date	Depth (ftKB)	Method	Comment
12/21/1993	7,130.0	CASED HOLE LOG	DEPTH LOGGER ON CBL
1/29/2009	6,712.0	TAG	2 SKS SAND ON TOP

Wellbore Sections

Section	Size (in)	Act Top (ftKB)	Act Btm (ftKB)
SURFACE PRODUCTION	12 1/4	9.0	340.0
	7 7/8	340.0	7,203.0

Zone Statuses

Zone	Status Date	Status	Job
CODELL	2/9/1984	PR	DRILLING/COMPLETION - ORIGI...
CODELL	3/12/2002	PR	RE-FRAC, 2/18/2002 00:00
CODELL	1/28/2009	SI	RECOMPLETION, 1/28/2009 06:00

Casing Strings

Surface, 335.0ftKB	Run Date	String ...	String Wt...	String ...	Top (ftKB)	Set Depth ...
Casing Description	12/6/1983	8 5/8	24.00	?	9.0	335.0

Production, 7,180.0ftKB

Casing Description	Run Date	String ...	String Wt...	String ...	Top (ftKB)	Set Depth ...
Production	12/14/1983	4 1/2	11.60	?	9.0	7,180.0

Cement

Description	Top (ftKB)	Bottom (ftKB)
SURFACE CASING CEMENT	9.0	335.0
Description	Top (ftKB)	Bottom (ftKB)
PRODUCTION CASING CEMENT	6,570.0	7,180.0

Tubing Components

Item Description	OD (in)	Wt (lbs/ft)	Grade	Jls	Len (ft)	Btm (ftKB)	Bottom Depth (TVD) (ftKB)
------------------	---------	-------------	-------	-----	----------	------------	---------------------------

Perforation Data

Zone	Bnch/Stg	Entered Shot Total	Top (ftKB)	Btm (ftKB)	Date
CODELL, ORIGINA...		72	7,063.0	7,080.0	2/19/2002
CODELL, ORIGINA...		21	7,067.0	7,077.0	12/26/1983

Stimulations & Treatments

Date	Zone	Primary Job Type
12/26/1983	CODELL, ORIGINAL HOLE	DRILLING/COMPLETION - ORIGINAL

Technical Result	Tech Result Details	Tech Result Notes
------------------	---------------------	-------------------

Comment

Date	Zone	Primary Job Type
2/27/2002	CODELL, ORIGINAL HOLE	RE-FRAC

Technical Result	Tech Result Details	Tech Result Notes
------------------	---------------------	-------------------

Comment

Other In Hole

Run Date	Description	OD (in)	Top (ftKB)	Btm (ftKB)
1/28/2009	Sand plug	4.2	6,815.0	7,180.0
1/29/2009	Retrieval Bridge Plug	4	6,706.0	6,712.0
1/29/2009	Sand plug	4.2	6,696.0	6,706.0
12/9/2011	FISH	3 7/8	2,222.0	2,224.0

Logs

Date	Type	Top (ftKB)	Btm (ftKB)
12/13/1983	DENSITY	4,000.0	7,185.0
12/13/1983	INDUCTION	335.0	7,203.0