


PLS Group, LLC
 109 Coronado Ct. - Bldg. 7
 Fort Collins, Colorado 80525
 P. 970-282-3446 Fx. 970-377-6767

WELL LOCATION CERTIFICATE

THIS MAP DOES NOT REPRESENT A BOUNDARY SURVEY

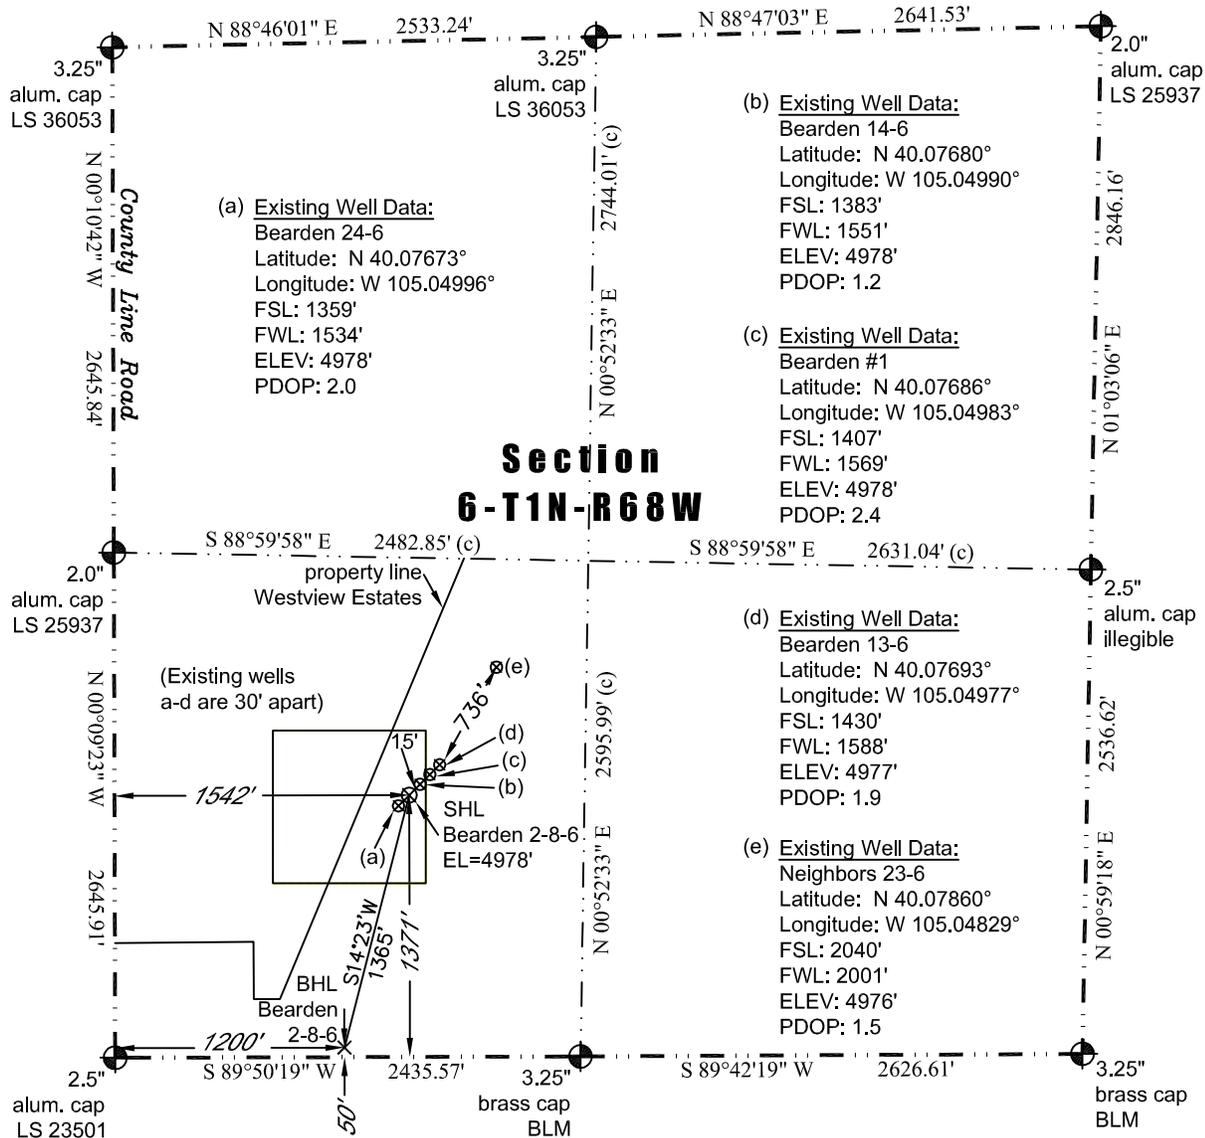

In accordance with a request from Jay Knutson of EnCana Oil & Gas (USA) Inc., PLS Group, LLC has determined the location of the **Bearden 2-8-6** well site to be SHL: 1371' FSL and 1542' FWL, (BHL 50' FSL and 1200' FWL), as measured at ninety (90) degrees from the section lines of Section 6, Township 1 North, Range 68 West of the 6th Principal Meridian, Weld County Colorado.

Proposed Surface Hole Data:

Latitude: N 40.07677° (BHL: 40.07314°)
 Longitude: W 105.04993° (BHL: 105.05117°)
 PDOP: 1.4

Nearest:


- Building 315' southwest
- Public Road 465' northwest
- Property Line 214' northwest
- Existing Well: Bearden 14-6 15' northeast
- Above Ground Utility 227' northwest
- Railroad 6,309' southeast
- Well Window: SHL is 87' inside

Notes:

- 1) Bearings and distances based on NAD 83 Colorado North State Plane Coordinates using RTK GPS observations taken 8/19/11 by operator Craig Burke.
- 2) Conversion factor to ground (1.000275448).
- 3) Elevations based on NAVD 88 GPS heights and Geoid 2003 corrections.
- 4) See Location Drawing for visible improvements within 400 feet of Pad Site.
- 5) The surface use is an uncultivated field.

NOTICE: According to Colorado law you must commence any legal action based upon any defect in this W.L.C. within three years after you first discover such defect. In no event may any action based upon any defect in this W.L.C. be commenced more than ten years from this said date of the certification shown hereon.

I hereby certify that this Well Location Certificate was prepared by me or under my direct supervision on 8/26/2011 for and on behalf of EnCana Oil & Gas (USA) Inc. That it is not a Land Survey Plat or an Improvement Survey Plat and that it is not to be relied upon for establishment of fences, buildings, or other future improvement lines.

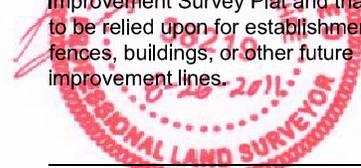

John Robert McGehee LS#38219
 Well: Bearden 2-8-6 WLC