



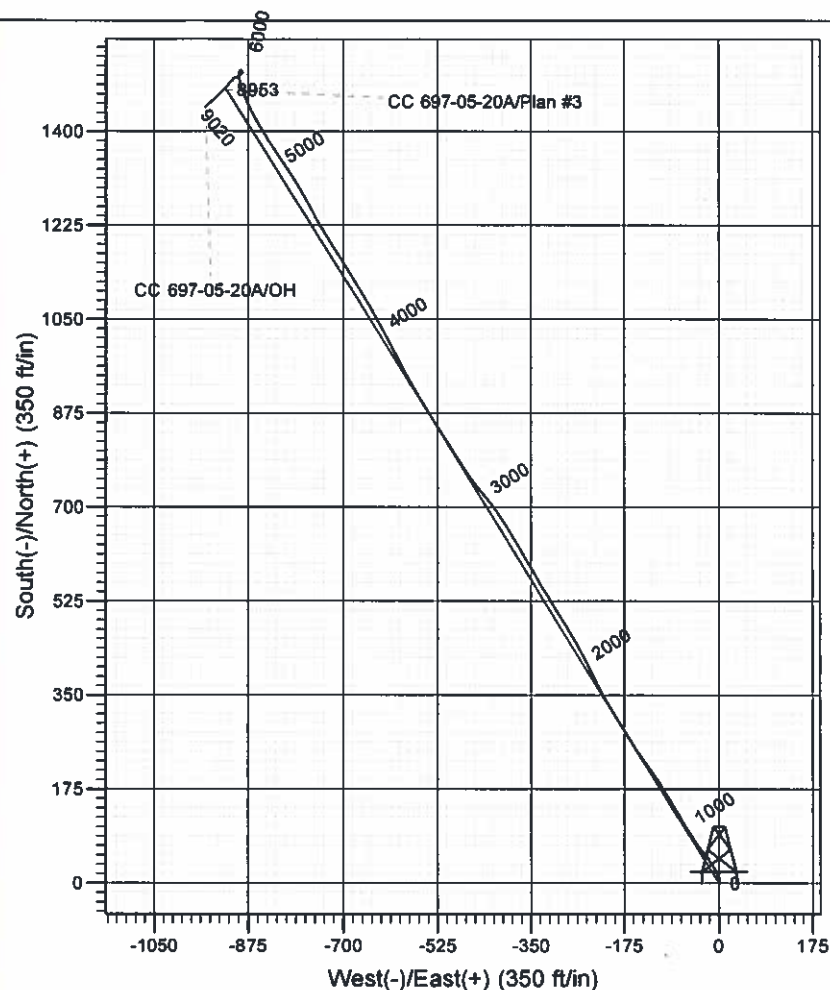

Scientific Drilling

Company: OXY USA RMAT
 Project: Garfield County, CO NAD27
 Site: Cascade Creek 697-06C Pad
 Well: CC 697-05-20A
 Wellbore: OH
 Design: OH

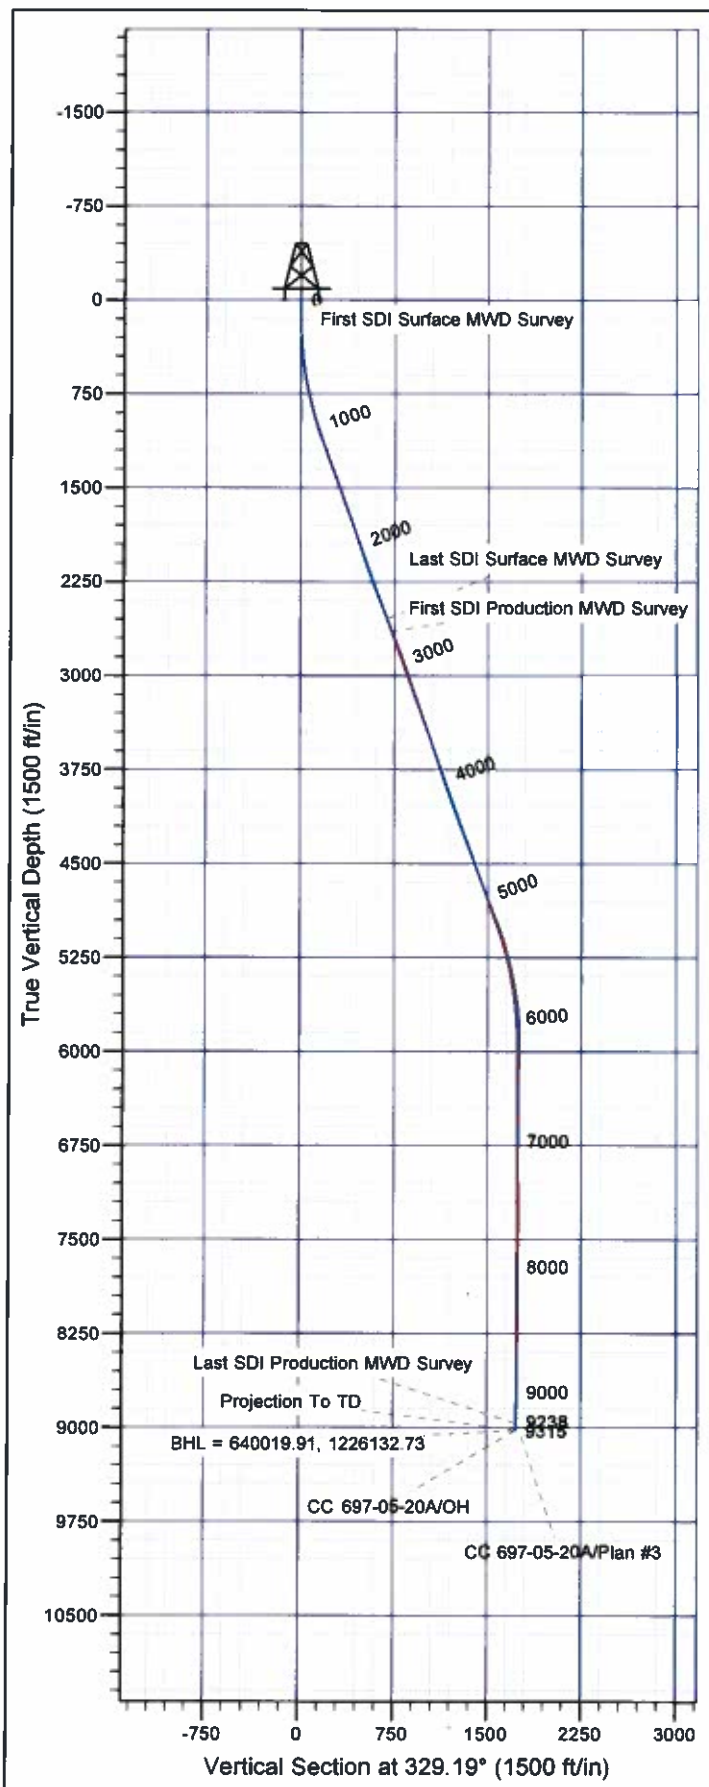

Well Details: CC 697-05-20A

| TVD Reference: GL 8423' & RKB 30' @ 8453.00ft (H&P 353) | | Datum Level: 8423.00 | | Slot Q | |
|---|-------|----------------------|------------|------------------|-------------------|
| +N/-S | +E/-W | Northing | Easting | Latitude | Longitude |
| 0.00 | 0.00 | 638546.00 | 1227041.74 | 39° 33' 16.587 N | 108° 14' 30.002 W |

REFERENCE INFORMATION

Co-ordinate (N/E) Reference: Well CC 697-05-20A - Slot Q, True North
 Vertical (TVD) Reference: GL 8423' & RKB 30' @ 8453.00ft (H&P 353)
 Section (VS) Reference: Slot - Q(0.00N, 0.00E)
 Measured Depth Reference: GL 8423' & RKB 30' @ 8453.00ft (H&P 353)
 Calculation Method: Minimum Curvature

PROJECT DETAILS: Garfield County, CO NAD27

Geodetic System: US State Plane 1927 (Exact solution)
 Datum: NAD 1927 (NADCON CONUS)
 Ellipsoid: Clarke 1866
 Zone: Colorado Central 502

System Datum: Mean Sea Level

Plan: OH

11:21, December 15 2011
 Created By: Rex Hall

OXY USA RMAT

Garfield County, CO NAD27

Cascade Creek 697-05C Pad

CC 697-05-20A - Slot Q

OH

Design: OH

Standard Survey Report

15 December, 2011

Scientific Drilling International

Survey Report

| | | | |
|------------------|---------------------------|-------------------------------------|--|
| Company: | OXY USA RMAT | Local Co-ordinate Reference: | Well CC 697-05-20A - Slot Q |
| Project: | Garfield County, CO NAD27 | TVD Reference: | GL 8423' & RKB 30' @ 8453.00ft (H&P 353) |
| Site: | Cascade Creek 697-05C Pad | MD Reference: | GL 8423' & RKB 30' @ 8453.00ft (H&P 353) |
| Well: | CC 697-05-20A | North Reference: | True |
| Wellbore: | OH | Survey Calculation Method: | Minimum Curvature |
| Design: | OH | Database: | Rockies Compass Server |

| | | | |
|--------------------|--------------------------------------|----------------------|----------------|
| Project | Garfield County, CO NAD27 | | |
| Map System: | US State Plane 1927 (Exact solution) | System Datum: | Mean Sea Level |
| Geo Datum: | NAD 1927 (NADCON CONUS) | | |
| Map Zone: | Colorado Central 502 | | |

| | | | | | |
|------------------------------|--|---------------------|-------------------|--------------------------|-------------------|
| Site | Cascade Creek 697-05C Pad, Sec. 5 T6S R97W | | | | |
| Site Position: | | Northing: | 637,463.43 usft | Latitude: | 39° 33' 5.626 N |
| From: | Map | Easting: | 1,226,150.07 usft | Longitude: | 108° 14' 40.963 W |
| Position Uncertainty: | 0.00 ft | Slot Radius: | 0.000 in | Grid Convergence: | -1.73 ° |

| | | | | | |
|-----------------------------|------------------------|---------|----------------------------|-------------------|-------------------------------------|
| Well | CC 697-05-20A - Slot Q | | | | |
| Well Position | +N/-S | 0.00 ft | Northing: | 638,546.00 usft | Latitude: 39° 33' 16.587 N |
| | +E/-W | 0.00 ft | Easting: | 1,227,041.74 usft | Longitude: 108° 14' 30.002 W |
| Position Uncertainty | | 0.00 ft | Wellhead Elevation: | ft | Ground Level: 8,423.00 ft |

| | | | | | |
|-----------------|----|--|--|--|--|
| Wellbore | OH | | | | |
|-----------------|----|--|--|--|--|

| Magnetics | Model Name | Sample Date | Declination (°) | Dip Angle (°) | Field Strength (nT) |
|------------------|-------------------|--------------------|----------------------------|--------------------------|--------------------------------|
| | IGRF2005-10 | 12/16/10 | 10.51 | 65.77 | 52,312 |

| | | | | | |
|---------------|----|--|--|--|--|
| Design | OH | | | | |
|---------------|----|--|--|--|--|

| | | | | | |
|---------------------|-----|---------------|--------|----------------------|------|
| Audit Notes: | | | | | |
| Version: | 1.0 | Phase: | ACTUAL | Tie On Depth: | 0.00 |

| Vertical Section: | Depth From (TVD) (ft) | +N/-S (ft) | +E/-W (ft) | Direction (°) |
|--------------------------|----------------------------------|-----------------------|-----------------------|--------------------------|
| | 0.00 | 0.00 | 0.00 | 329.19 |

| Survey Program | | Date | 12/15/11 | | |
|----------------|------------|---------------------------------|-----------|-----------------------|--|
| From (ft) | To (ft) | Survey (Wellbore) | Tool Name | Description | |
| 153.00 | 2,658.00 | Survey #1 - Surface MWD (OH) | MWD-SDI | MWD - Standard ISCWSA | |
| 2,763.00 | 9,315.00 | Survey #2 - Production MWD (OH) | MWD-SDI | MWD - Standard ISCWSA | |

| Survey | | | | | | | | | |
|-------------------------------------|----------------------------|------------------------|------------------------------------|-----------------------|-----------------------|--------------------------------------|--------------------------------------|-------------------------------------|------------------------------------|
| Measured Depth (ft) | Inclination (°) | Azimuth (°) | Vertical Depth (ft) | +N/-S (ft) | +E/-W (ft) | Vertical Section (ft) | Dogleg Rate (°/100ft) | Build Rate (°/100ft) | Turn Rate (°/100ft) |
| 0.00 | 0.00 | 0.00 | 0.00 | 0.00 | 0.00 | 0.00 | 0.00 | 0.00 | 0.00 |
| 153.00 | 0.61 | 19.28 | 153.00 | 0.77 | 0.27 | 0.52 | 0.40 | 0.40 | 0.00 |
| First SDI Surface MWD Survey | | | | | | | | | |
| 243.00 | 1.68 | 12.52 | 242.98 | 2.51 | 0.71 | 1.79 | 1.20 | 1.19 | -7.51 |
| 333.00 | 3.34 | 355.83 | 332.89 | 6.41 | 0.81 | 5.09 | 2.00 | 1.84 | -18.54 |
| 424.00 | 5.72 | 333.07 | 423.61 | 13.10 | -1.44 | 11.99 | 3.23 | 2.62 | -25.01 |
| 513.00 | 8.09 | 333.24 | 511.95 | 22.65 | -6.27 | 22.66 | 2.66 | 2.66 | 0.19 |
| 603.00 | 9.41 | 327.71 | 600.91 | 34.52 | -13.05 | 36.33 | 1.74 | 1.47 | -6.14 |
| 693.00 | 11.26 | 322.96 | 689.44 | 47.76 | -22.27 | 52.43 | 2.26 | 2.06 | -5.28 |
| 784.00 | 13.10 | 321.55 | 778.39 | 62.93 | -34.04 | 71.48 | 2.05 | 2.02 | -1.55 |

Scientific Drilling International

Survey Report

| | | | |
|------------------|---------------------------|-------------------------------------|--|
| Company: | OXY USA RMAT | Local Co-ordinate Reference: | Well CC 697-05-20A - Slot Q |
| Project: | Garfield County, CO NAD27 | TVD Reference: | GL 8423' & RKB 30' @ 8453.00ft (H&P 353) |
| Site: | Cascade Creek 697-05C Pad | MD Reference: | GL 8423' & RKB 30' @ 8453.00ft (H&P 353) |
| Well: | CC 697-05-20A | North Reference: | True |
| Wellbore: | OH | Survey Calculation Method: | Minimum Curvature |
| Design: | OH | Database: | Rockies Compass Server |

| Survey | | | | | | | | | |
|---------------------------------|-----------------|-------------|---------------------|------------|------------|-----------------------|-----------------------|----------------------|---------------------|
| Measured Depth (ft) | Inclination (°) | Azimuth (°) | Vertical Depth (ft) | +N/-S (ft) | +E/-W (ft) | Vertical Section (ft) | Dogleg Rate (°/100ft) | Build Rate (°/100ft) | Turn Rate (°/100ft) |
| 874.00 | 13.98 | 327.97 | 865.89 | 80.13 | -46.15 | 92.46 | 1.93 | 0.98 | 7.13 |
| 964.00 | 16.18 | 328.94 | 952.79 | 100.09 | -58.39 | 115.87 | 2.46 | 2.44 | 1.08 |
| 1,059.00 | 18.38 | 329.64 | 1,043.50 | 124.36 | -72.79 | 144.09 | 2.33 | 2.32 | 0.74 |
| 1,154.00 | 20.66 | 329.73 | 1,133.03 | 151.76 | -88.81 | 175.83 | 2.40 | 2.40 | 0.09 |
| 1,248.00 | 20.66 | 327.71 | 1,220.99 | 180.10 | -106.02 | 208.99 | 0.76 | 0.00 | -2.15 |
| 1,343.00 | 19.61 | 324.46 | 1,310.18 | 207.24 | -124.24 | 241.63 | 1.61 | -1.11 | -3.42 |
| 1,437.00 | 19.08 | 325.77 | 1,398.87 | 232.78 | -142.06 | 272.69 | 0.73 | -0.56 | 1.39 |
| 1,532.00 | 19.79 | 327.62 | 1,488.46 | 259.20 | -159.40 | 304.26 | 0.99 | 0.75 | 1.95 |
| 1,626.00 | 21.10 | 328.76 | 1,576.54 | 287.10 | -176.70 | 337.09 | 1.46 | 1.39 | 1.21 |
| 1,721.00 | 18.82 | 327.80 | 1,665.83 | 314.70 | -193.74 | 369.51 | 2.42 | -2.40 | -1.01 |
| 1,815.00 | 18.73 | 329.47 | 1,754.83 | 340.53 | -209.48 | 399.76 | 0.58 | -0.10 | 1.78 |
| 1,910.00 | 19.26 | 333.51 | 1,844.66 | 367.69 | -224.22 | 430.64 | 1.49 | 0.56 | 4.25 |
| 2,004.00 | 18.82 | 333.60 | 1,933.51 | 395.14 | -237.88 | 461.22 | 0.47 | -0.47 | 0.10 |
| 2,099.00 | 19.26 | 332.37 | 2,023.32 | 422.75 | -251.96 | 492.14 | 0.63 | 0.46 | -1.29 |
| 2,194.00 | 19.43 | 329.90 | 2,112.95 | 450.30 | -267.15 | 523.58 | 0.88 | 0.18 | -2.60 |
| 2,288.00 | 19.26 | 328.59 | 2,201.65 | 477.06 | -283.07 | 554.72 | 0.50 | -0.18 | -1.39 |
| 2,382.00 | 20.49 | 328.15 | 2,290.05 | 504.27 | -299.83 | 586.67 | 1.32 | 1.31 | -0.47 |
| 2,477.00 | 20.58 | 327.80 | 2,379.01 | 532.52 | -317.50 | 619.99 | 0.16 | 0.09 | -0.37 |
| 2,571.00 | 21.98 | 329.29 | 2,466.60 | 561.63 | -335.29 | 654.10 | 1.60 | 1.49 | 1.59 |
| 2,658.00 | 21.90 | 330.08 | 2,547.30 | 589.69 | -351.70 | 686.60 | 0.35 | -0.09 | 0.91 |
| Last SDI Surface MWD Survey | | | | | | | | | |
| 2,763.00 | 21.80 | 329.03 | 2,644.76 | 623.38 | -371.50 | 725.68 | 0.38 | -0.10 | -1.00 |
| First SDI Production MWD Survey | | | | | | | | | |
| 2,857.00 | 22.09 | 327.98 | 2,731.95 | 653.33 | -389.85 | 760.81 | 0.52 | 0.31 | -1.12 |
| 2,952.00 | 21.10 | 326.12 | 2,820.28 | 682.67 | -408.86 | 795.74 | 1.27 | -1.04 | -1.96 |
| 3,046.00 | 18.64 | 321.46 | 2,908.68 | 708.48 | -427.65 | 827.53 | 3.11 | -2.62 | -4.96 |
| 3,141.00 | 19.08 | 320.32 | 2,998.58 | 732.30 | -447.03 | 857.92 | 0.60 | 0.46 | -1.20 |
| 3,235.00 | 18.64 | 324.98 | 3,087.54 | 756.43 | -465.46 | 888.08 | 1.67 | -0.47 | 4.96 |
| 3,330.00 | 20.14 | 327.79 | 3,177.15 | 782.70 | -482.89 | 919.57 | 1.86 | 1.58 | 2.96 |
| 3,425.00 | 18.64 | 327.00 | 3,266.76 | 809.27 | -499.88 | 951.10 | 1.60 | -1.58 | -0.83 |
| 3,519.00 | 20.40 | 327.88 | 3,355.35 | 835.75 | -516.77 | 982.49 | 1.90 | 1.87 | 0.94 |
| 3,614.00 | 19.08 | 326.65 | 3,444.77 | 862.74 | -534.11 | 1,014.55 | 1.46 | -1.39 | -1.29 |
| 3,708.00 | 19.43 | 330.43 | 3,533.51 | 889.18 | -550.27 | 1,045.54 | 1.38 | 0.37 | 4.02 |
| 3,803.00 | 17.76 | 328.14 | 3,623.55 | 915.23 | -565.72 | 1,075.82 | 1.92 | -1.76 | -2.41 |
| 3,897.00 | 19.08 | 333.51 | 3,712.74 | 941.16 | -580.14 | 1,105.48 | 2.29 | 1.40 | 5.71 |
| 3,992.00 | 17.85 | 332.28 | 3,802.85 | 967.95 | -593.84 | 1,135.50 | 1.36 | -1.29 | -1.29 |
| 4,086.00 | 19.26 | 331.48 | 3,891.96 | 994.32 | -607.94 | 1,165.38 | 1.52 | 1.50 | -0.85 |
| 4,181.00 | 21.02 | 332.28 | 3,981.15 | 1,023.18 | -623.35 | 1,198.05 | 1.88 | 1.85 | 0.84 |
| 4,275.00 | 19.43 | 332.01 | 4,069.35 | 1,051.91 | -638.53 | 1,230.50 | 1.69 | -1.69 | -0.29 |
| 4,370.00 | 20.75 | 329.02 | 4,158.57 | 1,080.29 | -654.61 | 1,263.12 | 1.76 | 1.39 | -3.15 |
| 4,464.00 | 21.72 | 328.14 | 4,246.19 | 1,109.34 | -672.36 | 1,297.16 | 1.09 | 1.03 | -0.94 |
| 4,559.00 | 19.96 | 329.90 | 4,334.97 | 1,138.30 | -689.78 | 1,330.95 | 1.97 | -1.85 | 1.85 |
| 4,654.00 | 21.10 | 327.79 | 4,423.93 | 1,166.80 | -707.02 | 1,364.26 | 1.43 | 1.20 | -2.22 |

Scientific Drilling International

Survey Report

| | | | |
|------------------|---------------------------|-------------------------------------|--|
| Company: | OXY USA RMAT | Local Co-ordinate Reference: | Well CC 697-05-20A - Slot Q |
| Project: | Garfield County, CO NAD27 | TVD Reference: | GL 8423' & RKB 30' @ 8453.00ft (H&P 353) |
| Site: | Cascade Creek 697-05C Pad | MD Reference: | GL 8423' & RKB 30' @ 8453.00ft (H&P 353) |
| Well: | CC 697-05-20A | North Reference: | True |
| Wellbore: | OH | Survey Calculation Method: | Minimum Curvature |
| Design: | OH | Database: | Rockies Compass Server |

| Survey | | | | | | | | | |
|---------------------|-----------------|-------------|---------------------|------------|------------|-----------------------|-----------------------|----------------------|---------------------|
| Measured Depth (ft) | Inclination (°) | Azimuth (°) | Vertical Depth (ft) | +N/-S (ft) | +E/-W (ft) | Vertical Section (ft) | Dogleg Rate (°/100ft) | Build Rate (°/100ft) | Turn Rate (°/100ft) |
| 4,748.00 | 20.84 | 327.71 | 4,511.71 | 1,195.25 | -724.97 | 1,397.89 | 0.28 | -0.28 | -0.09 |
| 4,843.00 | 21.02 | 330.25 | 4,600.44 | 1,224.33 | -742.46 | 1,431.82 | 0.97 | 0.19 | 2.67 |
| 4,937.00 | 20.14 | 332.98 | 4,688.44 | 1,253.38 | -758.18 | 1,464.82 | 1.38 | -0.94 | 2.90 |
| 5,032.00 | 19.96 | 329.73 | 4,777.69 | 1,281.96 | -773.78 | 1,497.36 | 1.19 | -0.19 | -3.42 |
| 5,126.00 | 23.48 | 329.29 | 4,865.00 | 1,311.92 | -791.44 | 1,532.14 | 3.75 | 3.74 | -0.47 |
| 5,221.00 | 21.72 | 326.56 | 4,952.71 | 1,342.87 | -810.79 | 1,568.63 | 2.16 | -1.85 | -2.87 |
| 5,315.00 | 19.43 | 326.38 | 5,040.70 | 1,370.40 | -829.03 | 1,601.62 | 2.44 | -2.44 | -0.19 |
| 5,410.00 | 17.59 | 327.18 | 5,130.79 | 1,395.63 | -845.56 | 1,631.75 | 1.96 | -1.94 | 0.84 |
| 5,504.00 | 14.33 | 332.10 | 5,221.15 | 1,417.85 | -858.71 | 1,657.58 | 3.75 | -3.47 | 5.23 |
| 5,599.00 | 13.54 | 332.54 | 5,313.36 | 1,438.11 | -869.34 | 1,680.42 | 0.84 | -0.83 | 0.46 |
| 5,693.00 | 11.78 | 340.36 | 5,405.08 | 1,456.91 | -877.64 | 1,700.82 | 2.61 | -1.87 | 8.32 |
| 5,788.00 | 11.08 | 340.71 | 5,498.19 | 1,474.66 | -883.91 | 1,719.28 | 0.74 | -0.74 | 0.37 |
| 5,882.00 | 8.88 | 342.56 | 5,590.76 | 1,490.11 | -889.07 | 1,735.19 | 2.36 | -2.34 | 1.97 |
| 5,977.00 | 5.80 | 354.86 | 5,684.98 | 1,501.89 | -891.70 | 1,746.65 | 3.62 | -3.24 | 12.95 |
| 6,071.00 | 2.73 | 20.44 | 5,778.72 | 1,508.72 | -891.35 | 1,752.34 | 3.76 | -3.27 | 27.21 |
| 6,166.00 | 2.11 | 37.47 | 5,873.63 | 1,512.23 | -889.49 | 1,754.40 | 0.99 | -0.65 | 17.93 |
| 6,260.00 | 0.88 | 70.63 | 5,967.60 | 1,513.84 | -887.76 | 1,754.90 | 1.55 | -1.31 | 35.28 |
| 6,355.00 | 1.41 | 139.09 | 6,062.58 | 1,513.20 | -886.30 | 1,753.60 | 1.43 | 0.56 | 72.06 |
| 6,449.00 | 1.93 | 154.56 | 6,156.54 | 1,510.90 | -884.87 | 1,750.89 | 0.73 | 0.55 | 16.46 |
| 6,544.00 | 0.70 | 206.94 | 6,251.52 | 1,508.94 | -884.44 | 1,748.98 | 1.69 | -1.29 | 55.14 |
| 6,638.00 | 1.06 | 248.25 | 6,345.51 | 1,508.10 | -885.51 | 1,748.82 | 0.75 | 0.38 | 43.95 |
| 6,733.00 | 1.67 | 249.75 | 6,440.48 | 1,507.30 | -887.63 | 1,749.21 | 0.64 | 0.64 | 1.58 |
| 6,827.00 | 1.06 | 220.39 | 6,534.46 | 1,506.16 | -889.47 | 1,749.18 | 0.97 | -0.65 | -31.23 |
| 6,922.00 | 0.79 | 177.68 | 6,629.44 | 1,504.84 | -890.02 | 1,748.32 | 0.76 | -0.28 | -44.96 |
| 7,016.00 | 1.41 | 176.09 | 6,723.43 | 1,503.04 | -889.91 | 1,746.72 | 0.66 | 0.66 | -1.69 |
| 7,111.00 | 0.62 | 224.43 | 6,818.41 | 1,501.50 | -890.19 | 1,745.55 | 1.16 | -0.83 | 50.88 |
| 7,205.00 | 0.97 | 257.74 | 6,912.40 | 1,500.97 | -891.33 | 1,745.67 | 0.60 | 0.37 | 35.44 |
| 7,300.00 | 1.85 | 259.41 | 7,007.37 | 1,500.52 | -893.62 | 1,746.45 | 0.93 | 0.93 | 1.76 |
| 7,394.00 | 2.73 | 259.77 | 7,101.30 | 1,499.84 | -897.31 | 1,747.77 | 0.94 | 0.94 | 0.38 |
| 7,489.00 | 2.11 | 249.66 | 7,196.21 | 1,498.83 | -901.18 | 1,748.88 | 0.79 | -0.65 | -10.64 |
| 7,583.00 | 1.23 | 184.53 | 7,290.18 | 1,497.22 | -902.88 | 1,748.37 | 2.07 | -0.94 | -69.29 |
| 7,678.00 | 1.32 | 159.04 | 7,385.16 | 1,495.19 | -902.57 | 1,746.46 | 0.60 | 0.09 | -26.83 |
| 7,772.00 | 0.53 | 241.40 | 7,479.15 | 1,493.97 | -902.57 | 1,745.41 | 1.44 | -0.84 | 87.62 |
| 7,867.00 | 1.23 | 279.10 | 7,574.14 | 1,493.92 | -903.96 | 1,746.08 | 0.92 | 0.74 | 39.68 |
| 7,961.00 | 0.97 | 253.88 | 7,668.12 | 1,493.86 | -905.72 | 1,746.93 | 0.58 | -0.28 | -26.83 |
| 8,056.00 | 1.14 | 201.49 | 7,763.10 | 1,492.75 | -906.84 | 1,746.56 | 0.99 | 0.18 | -55.15 |
| 8,150.00 | 2.29 | 209.93 | 7,857.06 | 1,490.26 | -908.12 | 1,745.07 | 1.25 | 1.22 | 8.98 |
| 8,245.00 | 1.76 | 225.66 | 7,952.00 | 1,487.59 | -910.11 | 1,743.80 | 0.80 | -0.56 | 16.56 |
| 8,339.00 | 0.26 | 234.80 | 8,045.98 | 1,486.46 | -911.31 | 1,743.45 | 1.60 | -1.60 | 9.72 |
| 8,434.00 | 0.88 | 208.88 | 8,140.98 | 1,485.70 | -911.84 | 1,743.06 | 0.69 | 0.65 | -27.28 |
| 8,528.00 | 1.32 | 226.72 | 8,234.96 | 1,484.32 | -912.98 | 1,742.46 | 0.59 | 0.47 | 18.98 |
| 8,623.00 | 2.55 | 218.46 | 8,329.91 | 1,481.92 | -915.09 | 1,741.48 | 1.32 | 1.29 | -8.69 |
| 8,717.00 | 3.52 | 225.14 | 8,423.77 | 1,478.24 | -918.44 | 1,740.04 | 1.10 | 1.03 | 7.11 |
| 8,812.00 | 4.66 | 222.24 | 8,518.53 | 1,473.33 | -923.10 | 1,738.20 | 1.22 | 1.20 | -3.05 |

Scientific Drilling International

Survey Report

| | | | |
|------------------|---------------------------|-------------------------------------|--|
| Company: | OXY USA RMAT | Local Co-ordinate Reference: | Well CC 697-05-20A - Slot Q |
| Project: | Garfield County, CO NAD27 | TVD Reference: | GL 8423' & RKB 30' @ 8453.00ft (H&P 353) |
| Site: | Cascade Creek 697-05C Pad | MD Reference: | GL 8423' & RKB 30' @ 8453.00ft (H&P 353) |
| Well: | CC 697-05-20A | North Reference: | True |
| Wellbore: | OH | Survey Calculation Method: | Minimum Curvature |
| Design: | OH | Database: | Rockies Compass Server |

| Survey | | | | | | | | | |
|--|-----------------|-------------|---------------------|------------|------------|-----------------------|-----------------------|----------------------|---------------------|
| Measured Depth (ft) | Inclination (°) | Azimuth (°) | Vertical Depth (ft) | +N/-S (ft) | +E/-W (ft) | Vertical Section (ft) | Dogleg Rate (°/100ft) | Build Rate (°/100ft) | Turn Rate (°/100ft) |
| 8,906.00 | 4.48 | 227.51 | 8,612.23 | 1,468.02 | -928.37 | 1,736.35 | 0.49 | -0.19 | 5.61 |
| 9,001.00 | 3.87 | 227.42 | 8,706.98 | 1,463.35 | -933.47 | 1,734.94 | 0.64 | -0.64 | -0.09 |
| 9,095.00 | 4.57 | 226.63 | 8,800.72 | 1,458.63 | -938.53 | 1,733.48 | 0.75 | 0.74 | -0.84 |
| 9,190.00 | 5.10 | 227.42 | 8,895.39 | 1,453.17 | -944.39 | 1,731.80 | 0.56 | 0.56 | 0.83 |
| 9,260.00 | 5.28 | 230.59 | 8,965.10 | 1,449.02 | -949.17 | 1,730.68 | 0.48 | 0.26 | 4.53 |
| Last SDI Production MWD Survey | | | | | | | | | |
| 9,315.00 | 5.28 | 230.59 | 9,019.87 | 1,445.81 | -953.08 | 1,729.93 | 0.00 | 0.00 | 0.00 |
| Projection To TD - BHL = 640019.91, 1226132.73 | | | | | | | | | |

| Design Annotations | | | | |
|---------------------|---------------------|-------------------|------------|---------------------------------|
| Measured Depth (ft) | Vertical Depth (ft) | Local Coordinates | | Comment |
| | | +N/-S (ft) | +E/-W (ft) | |
| 153.00 | 153.00 | 0.77 | 0.27 | First SDI Surface MWD Survey |
| 2,658.00 | 2,547.30 | 589.69 | -351.70 | Last SDI Surface MWD Survey |
| 2,763.00 | 2,644.76 | 623.38 | -371.50 | First SDI Production MWD Survey |
| 9,260.00 | 8,965.10 | 1,449.02 | -949.17 | Last SDI Production MWD Survey |
| 9,315.00 | 9,019.87 | 1,445.81 | -953.08 | Projection To TD |
| 9,315.00 | 9,019.87 | 1,445.81 | -953.08 | BHL = 640019.91, 1226132.73 |

| | | |
|-------------------|--------------------|-------------|
| Checked By: _____ | Approved By: _____ | Date: _____ |
|-------------------|--------------------|-------------|