


Stell Surveying Services, LLC

1102 West 19th Street P.O. BOX 2073  
ACCESS ROAD MAP

Cheyenne, Wyoming 82001

SECTION 12  
TOWNSHIP 3 NORTH  
RANGE 65 WEST

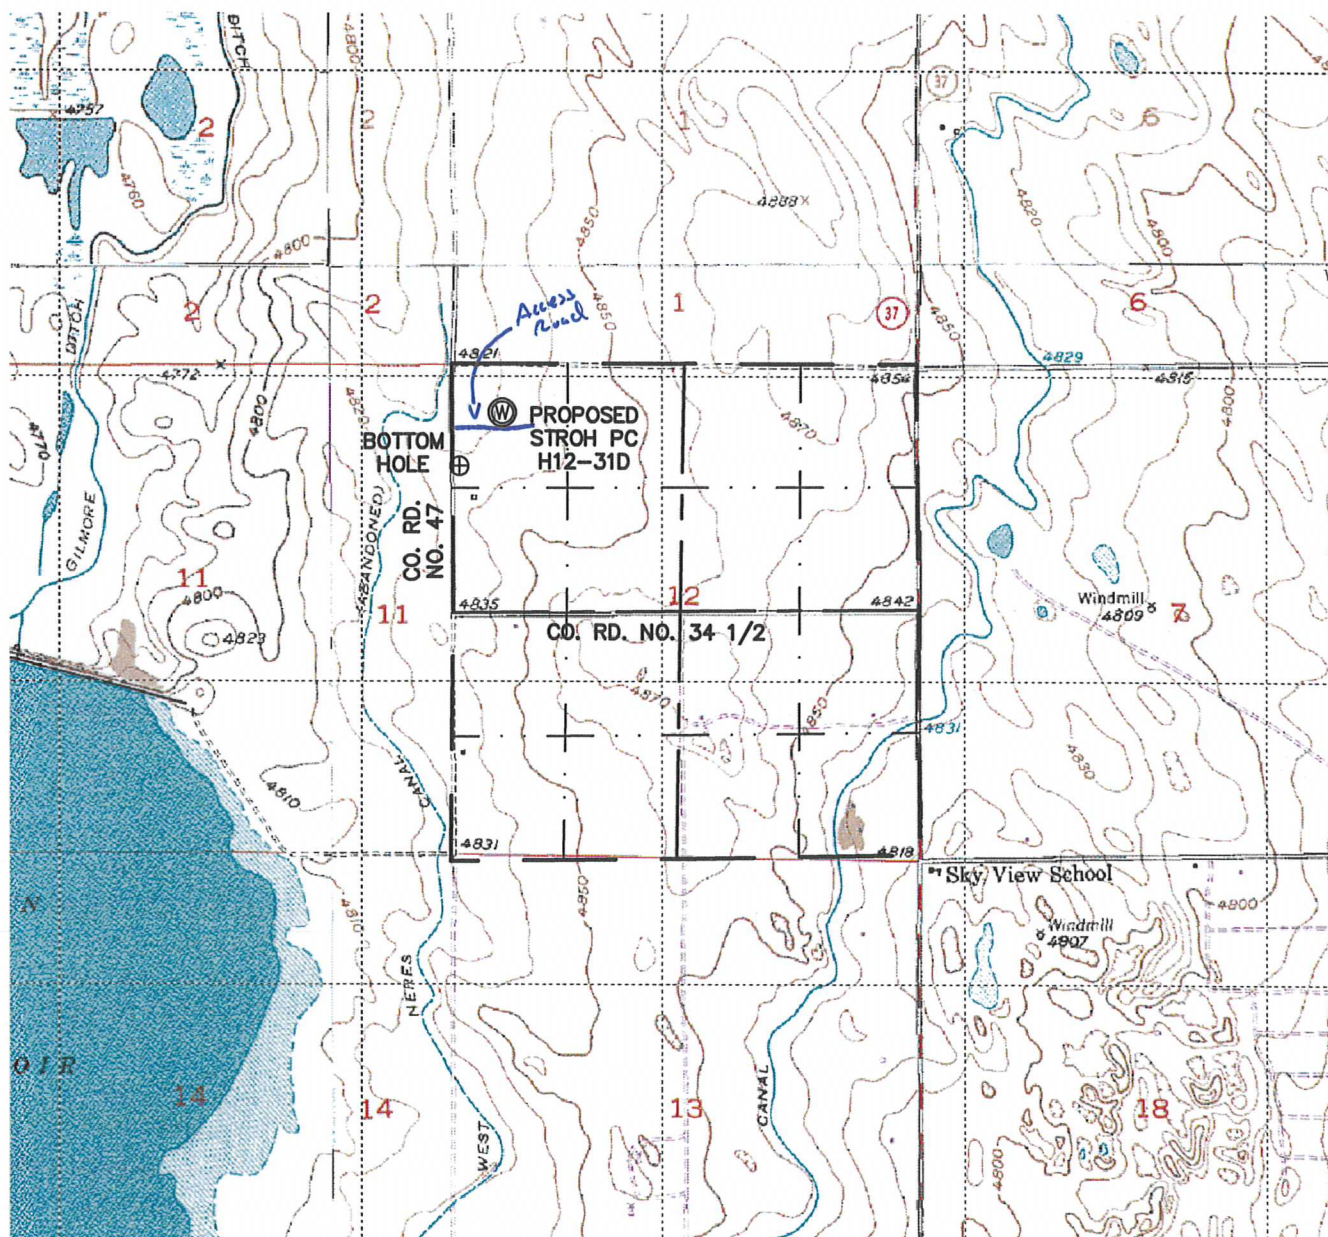

0 2000

Scale: 1" = 2000'