


# WELL LOCATION CERTIFICATE

THIS MAP DOES NOT REPRESENT A BOUNDARY SURVEY


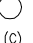
SECTION 8  
TOWNSHIP 4 NORTH  
RANGE 67 WEST

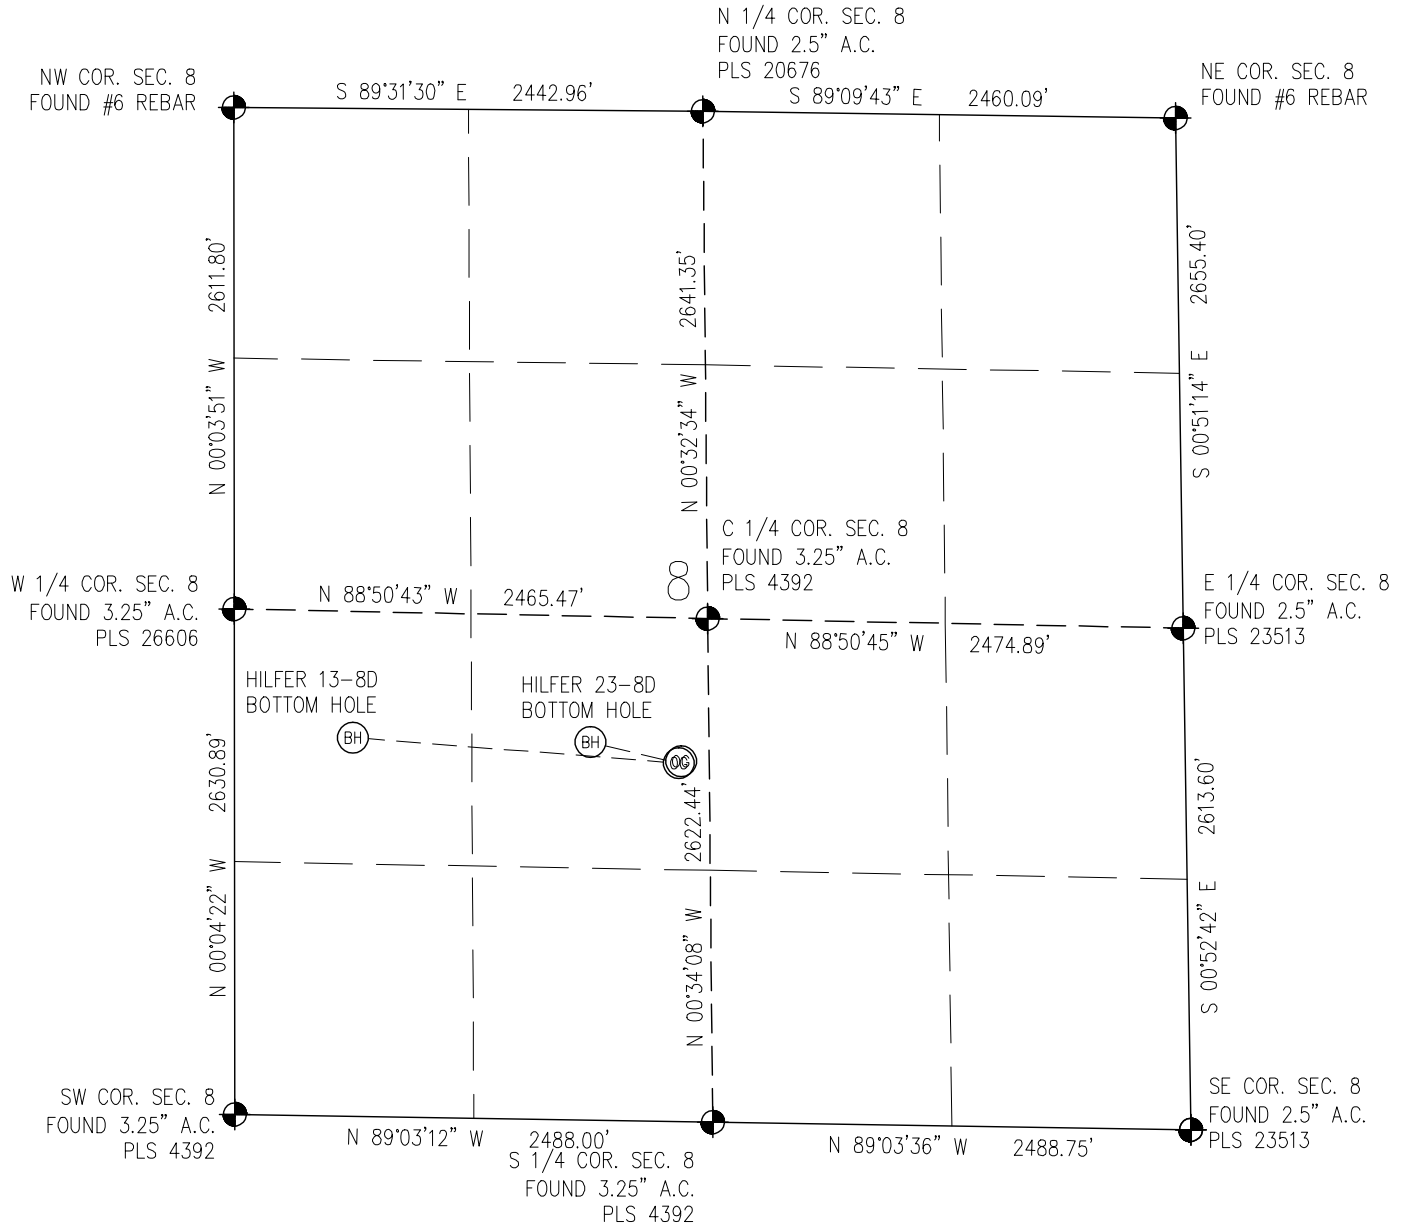

0 1000  
Scale 1" = 1000 ft



## LEGEND

-  - FOUND/SET SURVEY MONUMENT PER MONUMENT RECORD EXCEPTIONS NOTED.
-  - CALCULATED SURVEY MONUMENT POSITION
- (C) - CALCULATED DIMENSION