

CHEVRON U.S.A., INC.


RECLAMATION DIAGRAM FOR

CARNEY CT EL AL 45X35
SECTION 35, T2N, R102W, 6th P.M.
38' FNL 2487' FWL

FIGURE #4




SCALE: 1" = 50'
DATE: 02-07-11
DRAWN BY: S.B.
REVISED: 09-01-11

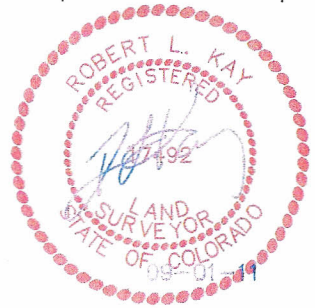

Legend:

ST - SEDIMENT TRAP
RV - REVEGETATION
W - WATTLE

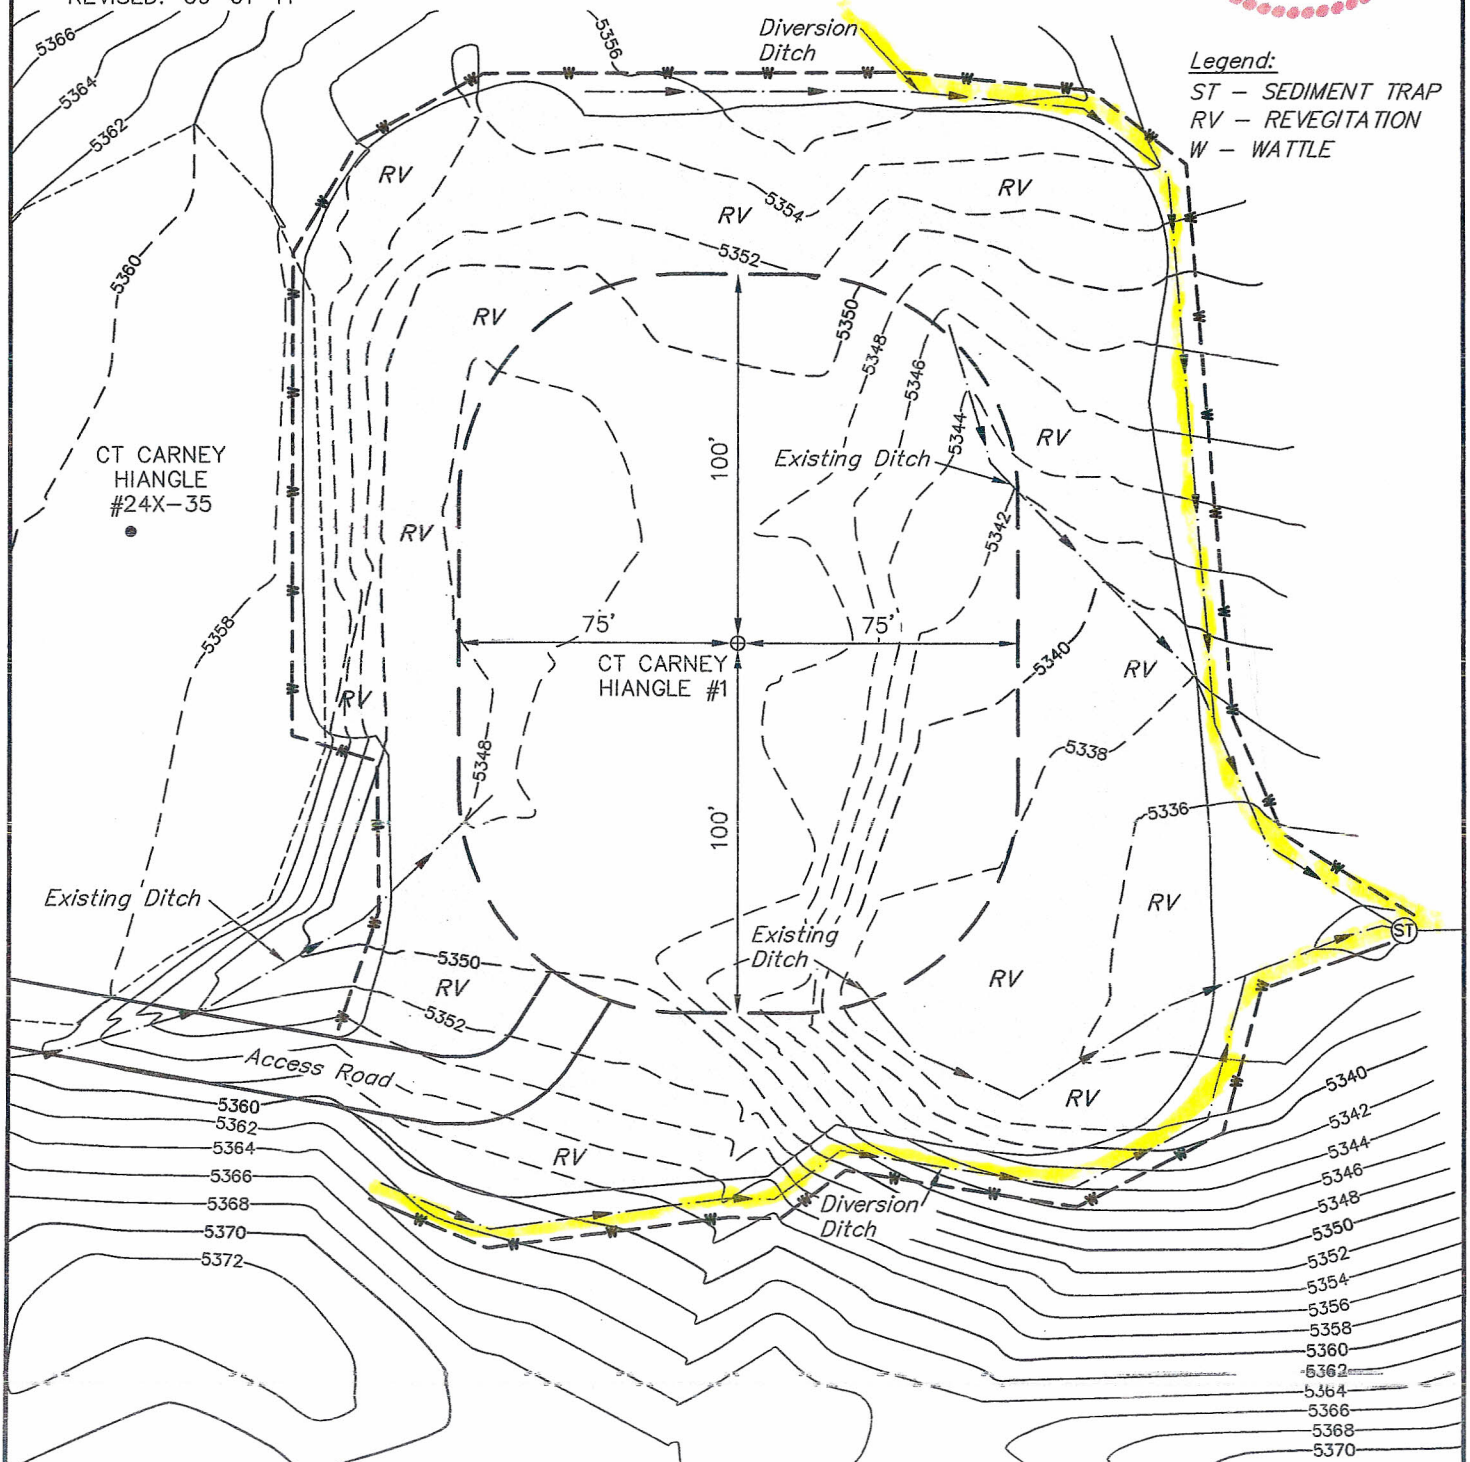

UINTAH ENGINEERING & LAND SURVEYING
85 So. 200 East * Vernal, Utah 84078 * (435) 789-1017