High Prairie Survey Co.

Physical Address: 345 Comanche St.
Mail to: Box 384 Kiowa, CO 80117
Ph. 303-621-8672 - Fax 303-621-2717
www.highprairiesurvey.com

Job # 11216 Larsen Unit 1-24

TOPO MAP

High Prairie Surveying of Kiowa, Colorado has in accordance with a request from **Mull Drilling Co.** has determined the location of **Larsen Unit 1-24** to be 2537 feet FSL, and 923' FWL, (90° off Section lines) **of** SECTION 24, Township **17s**, Range **45w** of the 6th Principal Meridian, **Kiowa County**, Colorado.

Date: Staked on December 7, 2011, drawn on December 8, 2011.

Re: Staked by Keith Westfall
Drawn: Drawn by Elijah Frane

Basis of Elevation Spot: USGS BM = SNAKE, PID = JJ0809, H-Order = Third, V-Order = Scaled, Stability = C, P-DOP = 3.1, Sats = 9 US NAD 83 CO-S, Lat. = 38.45290, Long. = 102.40390, Elevation = 3996 gr. (us FT).

Notes: There are no apparent improvements within 400 ft of proposed well pad.
The ground elevation at staked location = 4108.99' gr.
This drawing does not represent a monumented survey or Land Survey Plat.

Basis of Bearing: Bearings were determined based on the North line of Section 24 to bear N 83°13'05" E with all other bearings contained herein relative thereto.
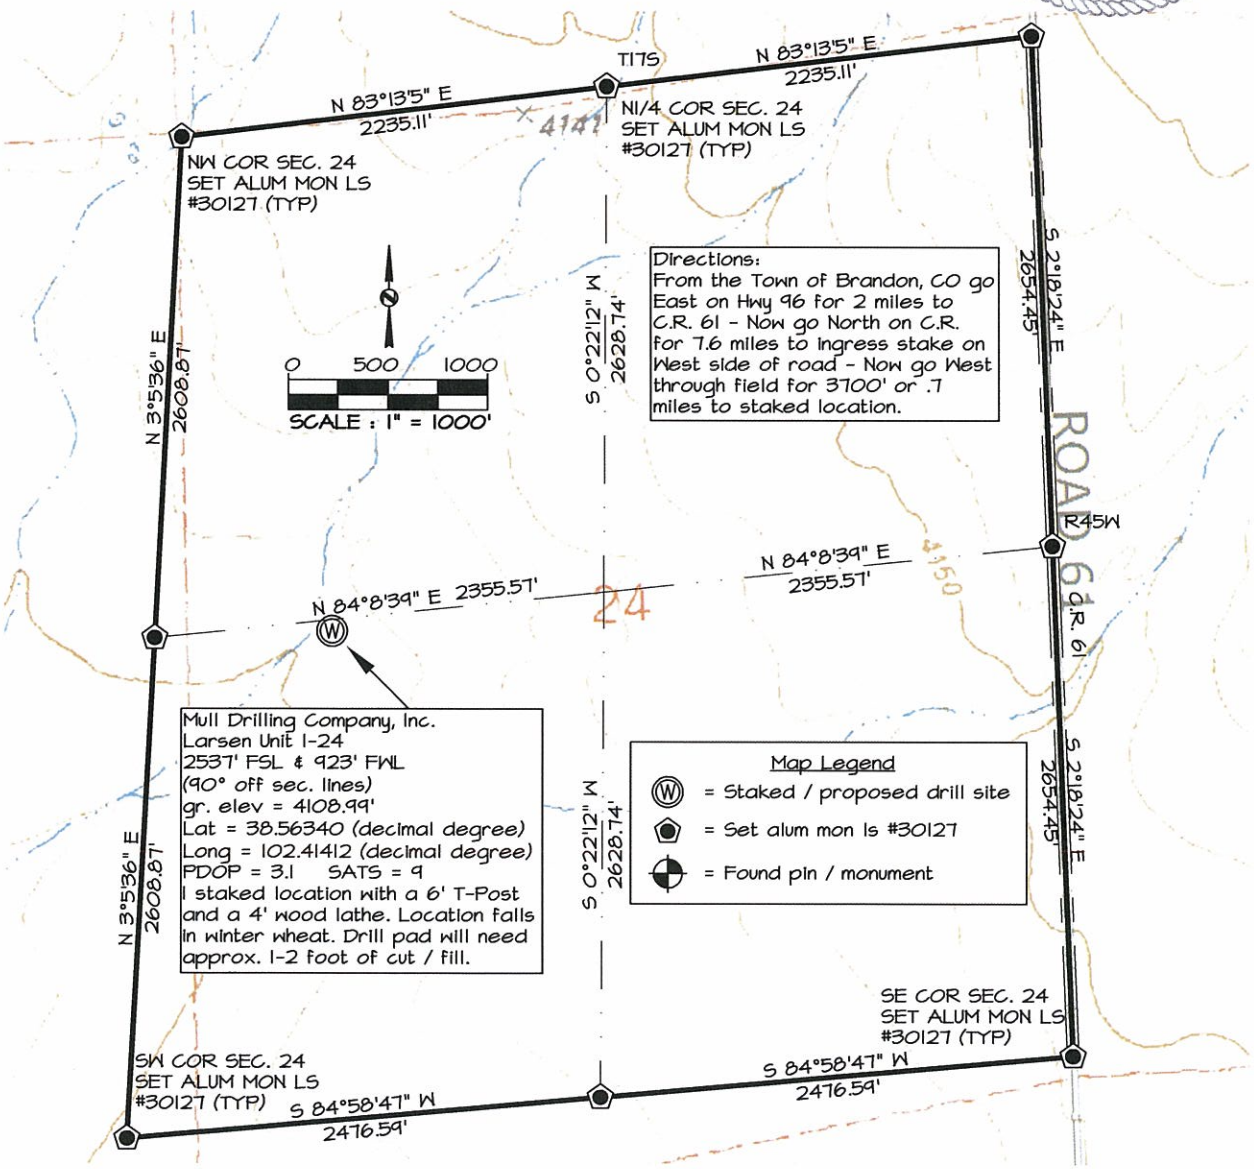
COLORADO LICENSED KEITH WESTFALL 30127 PROFESSIONAL LAND SURVEYOR