


WELL LOCATION CERTIFICATE

SECTION: 13
TOWNSHIP: 4N
RANGE: 65W

THIS MAP DOES NOT REPRESENT A BOUNDARY SURVEY

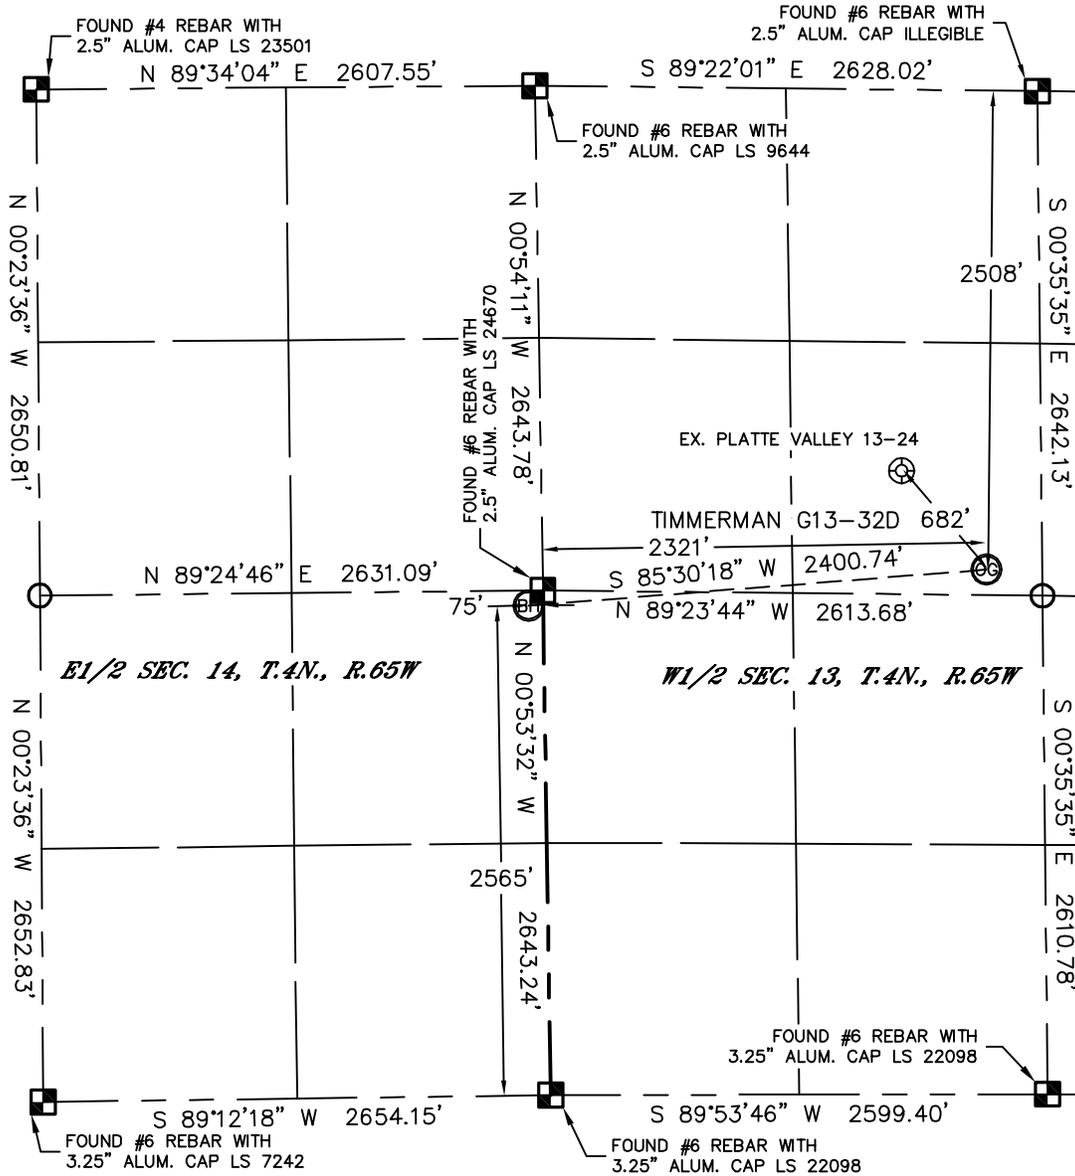

In accordance with a request from Nate McCorkell with Noble Energy Inc. Lat40°, Inc. has determined the surface location of the TIMMERMAN G13-32D to be 2508' from the NORTH line and 2321' from the WEST line as measured at right angles from the section lines of Section 13, Township 4 North, Range 65 West and the bottom hole to be 2565' from the SOUTH line and 75' from the EAST line as measured at right angles from the section lines of Section 14, Township 4 North, Range 65 West of the Sixth Principal Meridian, County of Weld, State of Colorado.

I hereby state that this Well Location Certificate was prepared by me, or under my direct supervision, that the fieldwork was completed on 8/26/11, for and on behalf of Noble Energy Inc. That this is not a Land Survey Plat or an Improvement Survey Plat, and that it is not to be relied upon for establishment of fence, building, or other future improvement lines.

SURFACE LOCATION	BOTTOM HOLE
LATITUDE: 40.31271°N	LATITUDE: 40.31226°N
LONGITUDE: 104.61251°W	LONGITUDE: 104.62110°W
PDOP: 1.9	
ELEV: 4775'	
1/4,1/4: SE1/4NW1/4	
NEAREST PROPERTY LINE: 133' SOUTH	

NOTE:


- 1) Bearings shown are Grid Bearings of the Colorado State Plane Coordinate System, North Zone, North American Datum 1983/2007. The lineal dimensions as contained herein are based upon the "U.S. Survey Foot."
- 2) Ground elevations are based on an observed GPS elevation (NAVD 1988 DATUM).
- 3) NEAREST EXISTING WELL: PLATTE VALLEY 13-24, 682'
- 4) IMPROVEMENTS: See LOCATION DRAWING for all visible improvements within 400' of disturbed area.
- 5) SURFACE USE: GRASSLAND/PASTURE
- 6) INSTRUMENT OPERATOR: KYLE RUTZ

NOTE

According to Colorado law, you must commence any legal action based upon any defect in this W.L.C. within three years after you discover such defect. In no event, may any action based upon any defect in this survey be commenced more than ten years after the date of the certificate shown hereon. (13-80-105 C.R.S.)

LEGEND

-  = ALIQUOT MONUMENT AS DESCRIBED
-  = CALCULATED POSITION

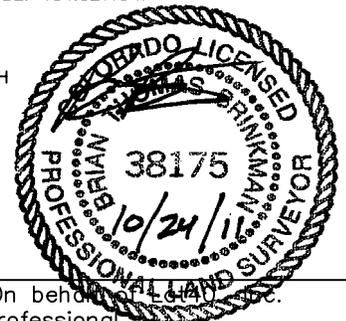


Brian T. Brinkman—On behalf of Lat40, Inc.
Colorado Licensed Professional
Land Surveyor No. 38175 PROJECT# 2011219

SITE SKETCH

TIMMERMAN G13-32D

SECTION: 13
TOWNSHIP: 4N
RANGE: 65W

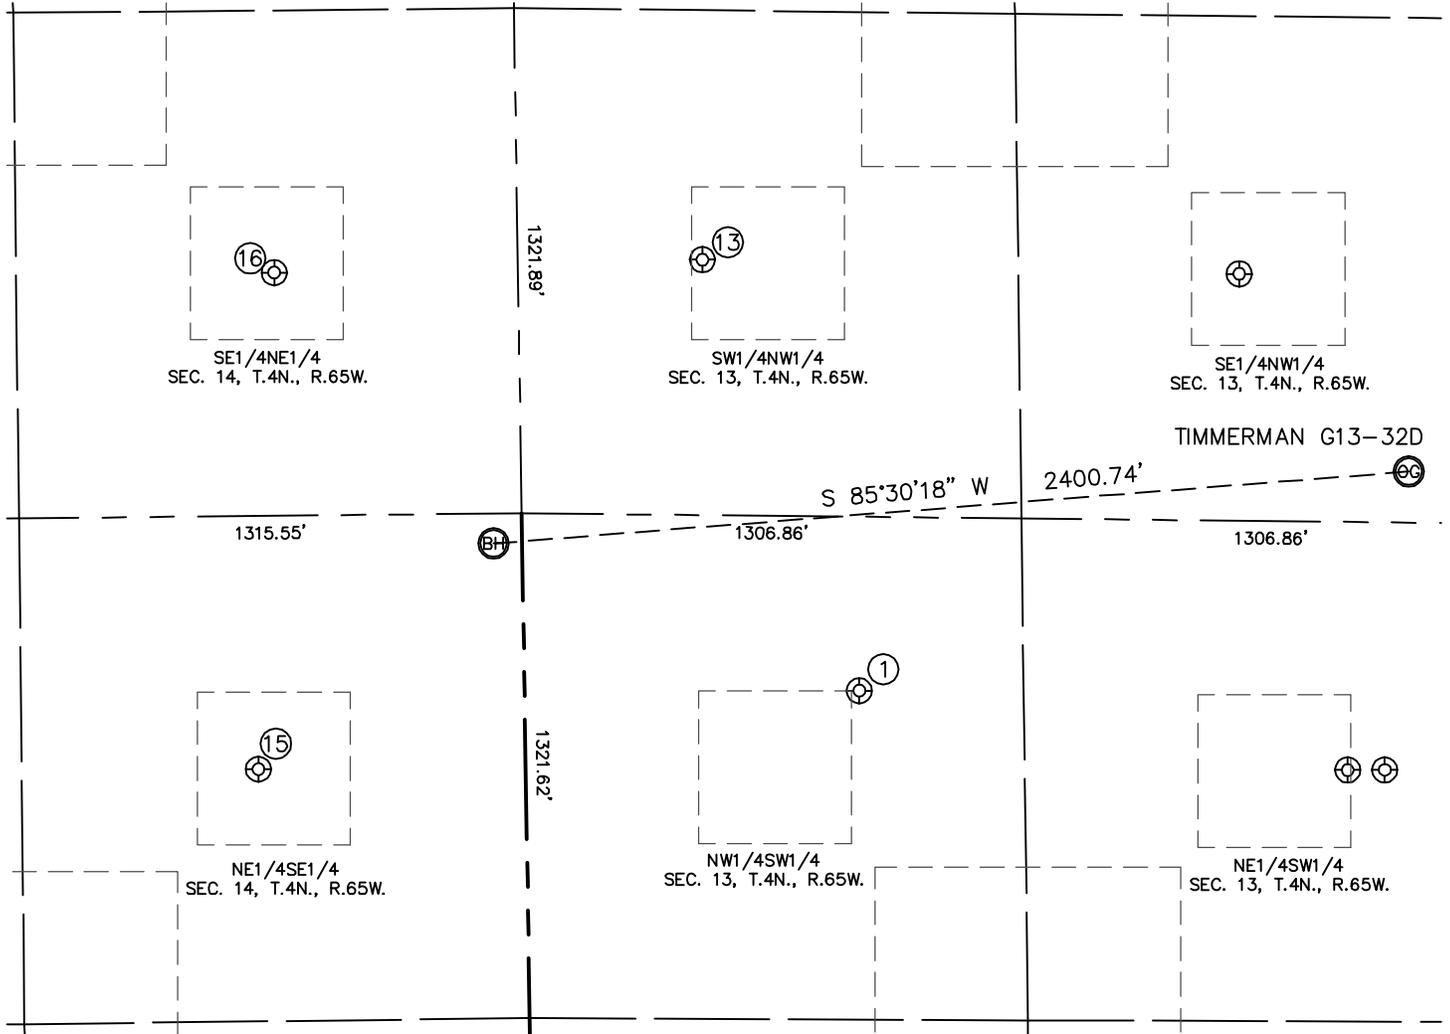

①
TIMMERMAN 13-13
NW1/4SW1/4
2177' FSL
875' FWL
LAT-40.31117°N
LONG-104.61768°W
PDOP: 1.4
ELEV: 4755'

⑬
BOHLENDER 13-1
SW1/4NW1/4
1974' FNL
483' FWL
LAT-40.31428°N
LONG-104.61911°W
PDOP: 1.1
ELEV: 4739'

⑮
SALLEE 14-2
NE1/4SE1/4
1983' FSL
699' FEL
LAT-40.31065°N
LONG-104.62332°W
PDOP: 1.7
ELEV: 4722'

⑯
SUN & SOIL 2-14
SE1/4NE1/4
2009' FNL
638' FEL
LAT-40.31422°N
LONG-104.62313°W
PDOP: 1.1
ELEV: 4719'

