




Lease Name: Pratt #29PD

Legals: SESE – Sec. 29, T1N, R68W

County: Weld County, Colorado

API#: 05-123-32857

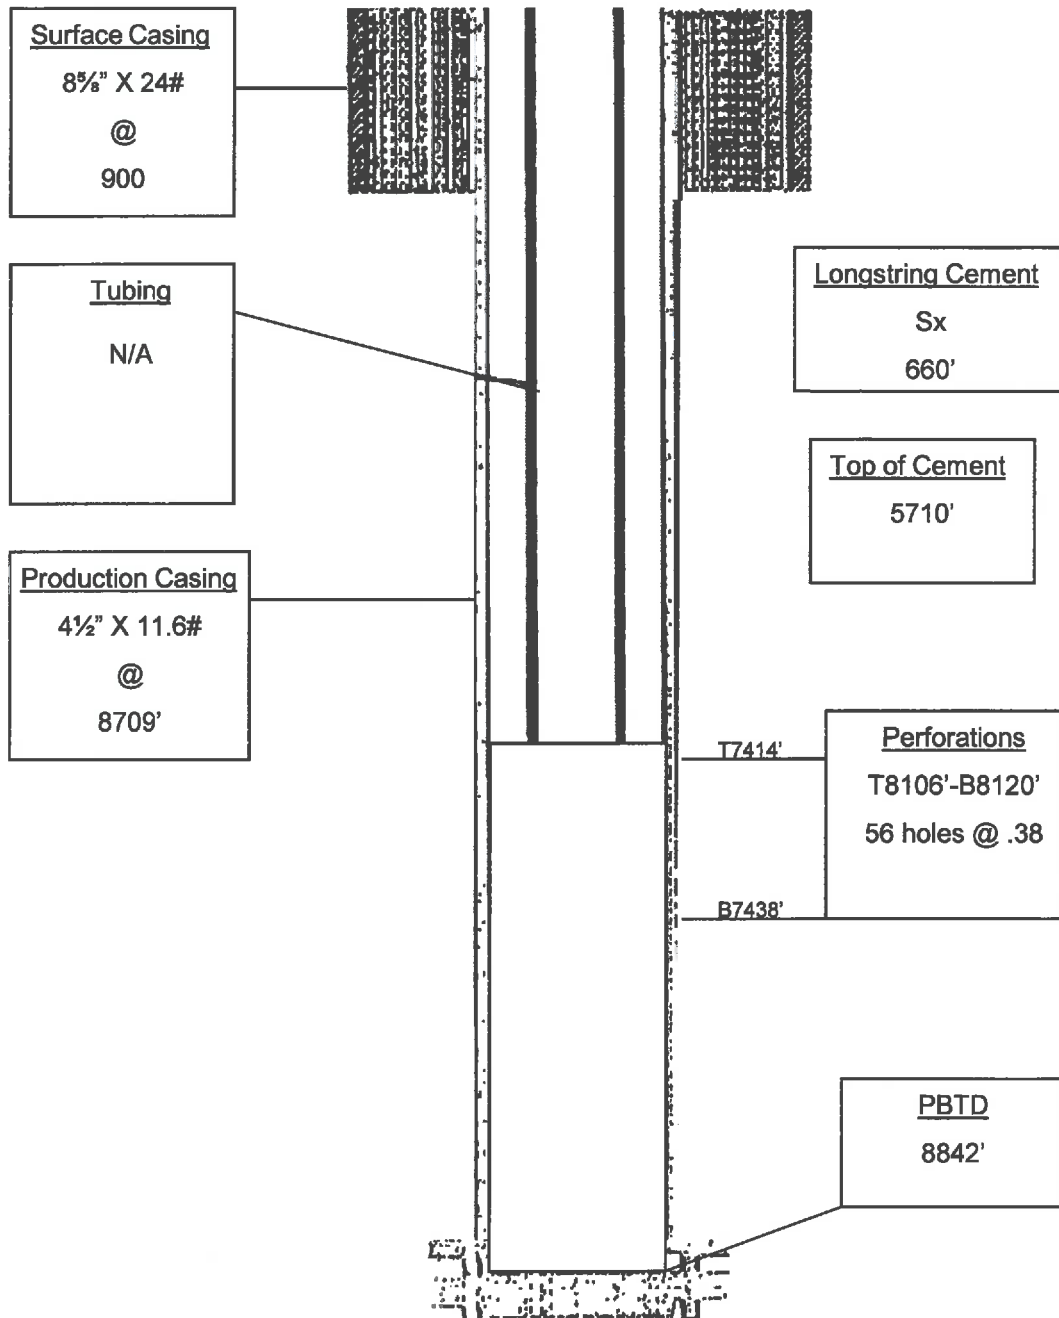

Wellbore Diagram