



02577925

FORM 4 Rev 12/05

Page 1

State of Colorado Oil and Gas Conservation Commission

1120 Lincoln Street, Suite 801, Denver, Colorado 80203 Phone: (303)894-2100 Fax: (303)894-2109



RECEIVED JAN 10 2012 COGCC/Rifle Office

SUNDRY NOTICE

Submit original plus one copy. This form is to be used for general, technical and environmental sundry information. For proposed or completed operations, describe in full on Technical Information Page (Page 2 of this form.) Identify well or other facility by API Number or by OGCC Facility ID. Operator shall send an informational copy of all sundry notices for wells located in High Density Areas to the Local Government Designee (Rule 603b.)

1. OGCC Operator Number: 10079 4. Contact Name: Hannah Knopping 2. Name of Operator: Antero Resources Piceance Corporation 3. Address: 1625 17th Street, Suite 300 City: Denver State: CO Zip: 80202 5. API Number 05-045-20139-00 6. Well/Facility Name: McLin 7. Well/Facility Number: C19 8. Location (Qtr/Qtr, Sec, Twp, Rng, Meridian): NESE, Section 13, T6S, R92W of the 6th PM 9. County: Garfield 10. Field Name: Mamm Creek 11. Federal, Indian or State Lease Number: Complete the Attachment Checklist of OGCC

General Notice

CHANGE OF LOCATION: Attach New Survey Plat (a change of surface qtr/qtr is substantive and requires a new permit) Change of Surface Footage from Exterior Section Lines: Change of Surface Footage to Exterior Section Lines: Change of Bottomhole Footage from Exterior Section Lines: Change of Bottomhole Footage to Exterior Section Lines: GPS DATA: CHANGE SPACING UNIT: CHANGE OF OPERATOR (prior to drilling): CHANGE WELL NAME: ABANDONED LOCATION: NOTICE OF CONTINUED SHUT IN STATUS: SPUD DATE: REQUEST FOR CONFIDENTIAL STATUS: SUBSEQUENT REPORT OF STAGE, SQUEEZE OR REMEDIAL CEMENT WORK: RECLAMATION:

Technical Engineering/Environmental Notice

Notice of Intent Report of Work Done Approximate Start Date 1/17/2012 Date Work Completed: Details of work must be described in full on Technical Information Page (Page 2 must be submitted.) Intent to Recomplete (submit form 2) Request to Vent or Flare E&P Waste Disposal Change Drilling Plans Repair Well Beneficial Reuse of E&P Waste Gross Interval Changed? Rule 502 variance requested Status Update/Change of Remediation Plans Casing/Cementing Program Change Other: Request to Complete for Spills and Releases

I hereby certify that the statements made in this form are, to the best of my knowledge, true, correct and complete.

Signed: Hannah Knopping Date: 1/10/12 Email: hknopping@anteroresources.com Print Name: Hannah Knopping Title: Permit Representative

COGCC Approved: [Signature] Title: EIT III Date: JAN 11 2012

CONDITIONS OF APPROVAL, IF ANY:

TECHNICAL INFORMATION PAGE



FOR OGCC USE ONLY

RECEIVED

JAN 10 2012

COGCC/Rifle Office

1. OGCC Operator Number: 10079 API Number: 05-045-20139-00

2. Name of Operator: Antero Resources Piceance Corp. OGCC Facility ID # _____

3. Well/Facility Name: McLin Well/Facility Number: C19

4. Location (QtrQtr, Sec, Twp, Rng, Meridian): NESE, Section 13, T6S, R92W of the 6th PM

This form is to be completed whenever a Sundry Notice is submitted requiring detailed report of work to be performed or completed. This form shall be transmitted within 30 days of work completed as a "subsequent" report and must accompany Form 4, page 1.

5. DESCRIBE PROPOSED OR COMPLETED OPERATIONS

The McLin C19 has been successfully cemented according to the approved plan and a summary of the braden head monitoring is listed below. Eleven Hundred and twenty five (1,125) sacks of cement were used to cover the Top of Gas as per Colorado Oil and Gas Conservation Commission rules. Appropriate industry practices and procedures were utilized on the McLin C19 cementing program. The cement bond log indicates good zonal isolation and coverage from TD to 985'. I, Jonathon Black, certify that all the information contained within this Sundry is true and correct.

Date Cemented: 12/18/2011

Plug Bumped: 12/18/2011@12:00 PM

WOC Time: 6 Hrs.

Temp Log Run: 12/18/2011 18:00 PM

Casing mandrel set: 12/18/2011@09:00 AM


Braden Head Pressures:

6 hours: 0 psig	18:00 PM 12/18/2011
12 hours 0 psig	00:00 AM 12/19/2011
24 hours 0 psig	12:00 PM 12/19/2011
48 hours 0 psig	12:00 PM 12/20/2011
72 hours 0 psig	12:00 PM 12/21/2011
96 hours 0 psig	12:00 PM 12/22/2011
120 hours 0 psig	12:00 PM 12/23/2011
144 hours 0 psig	12:00 PM 12/24/2011
168 hours 0 psig	12:00 PM 12/25/2011


TOC 1070'
KK

NOTE: Antero received approval from COGCC Engineer, Kevin King, on 12/23/2011, to defer running the CBL on the subject well, per Mamm Creek Notice to Operators policy.

- ATTACHMENTS:
- 1) Cement Bond Log
 - 2) 1-Page Temperature Survey
 - 3) Wellbore Schematic

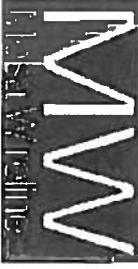


Company ANTERO RESOURCES PICEANCE CORP.
Well McLIN C19
Legal Desc. S: 13 TWP: 06S RNG:92W Date 18 DEC 2011
County GARFIELD State COLORADO
API# 05-045-20139-0000

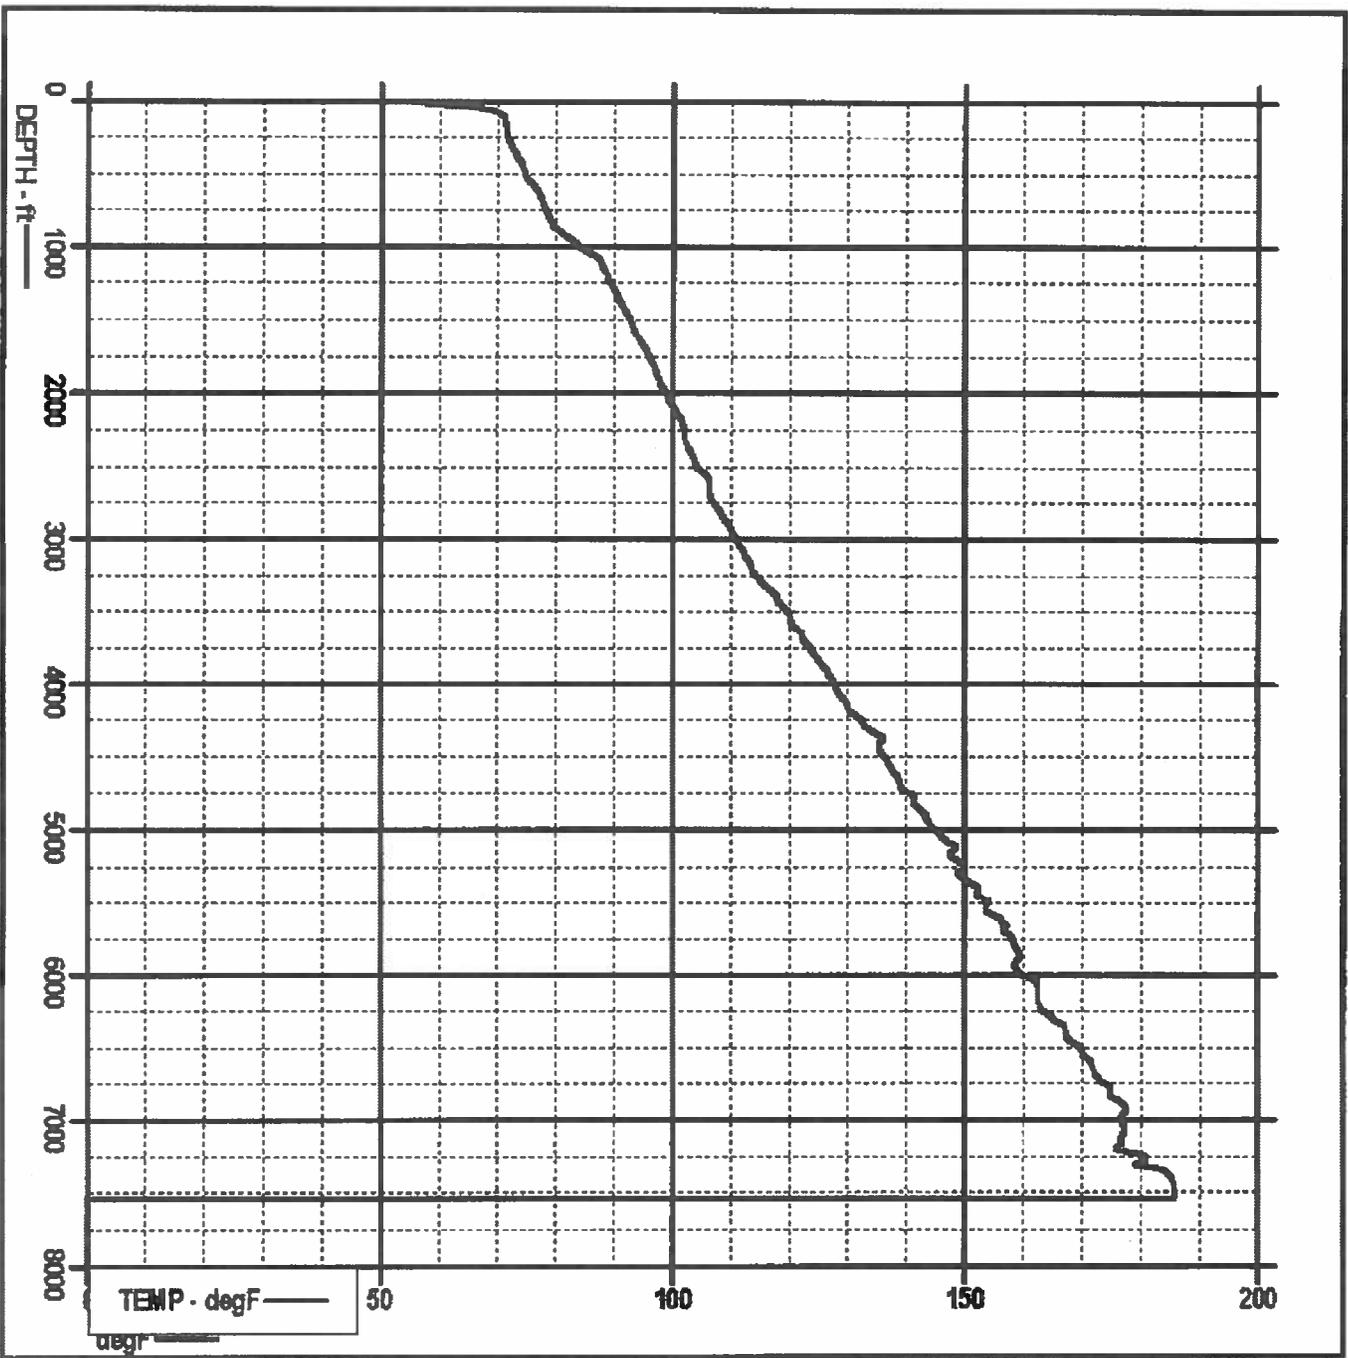

RECEIVED
JAN 10 2012
COGCC/Rifle Office

Geological Schematic

Well Name: McLin C19

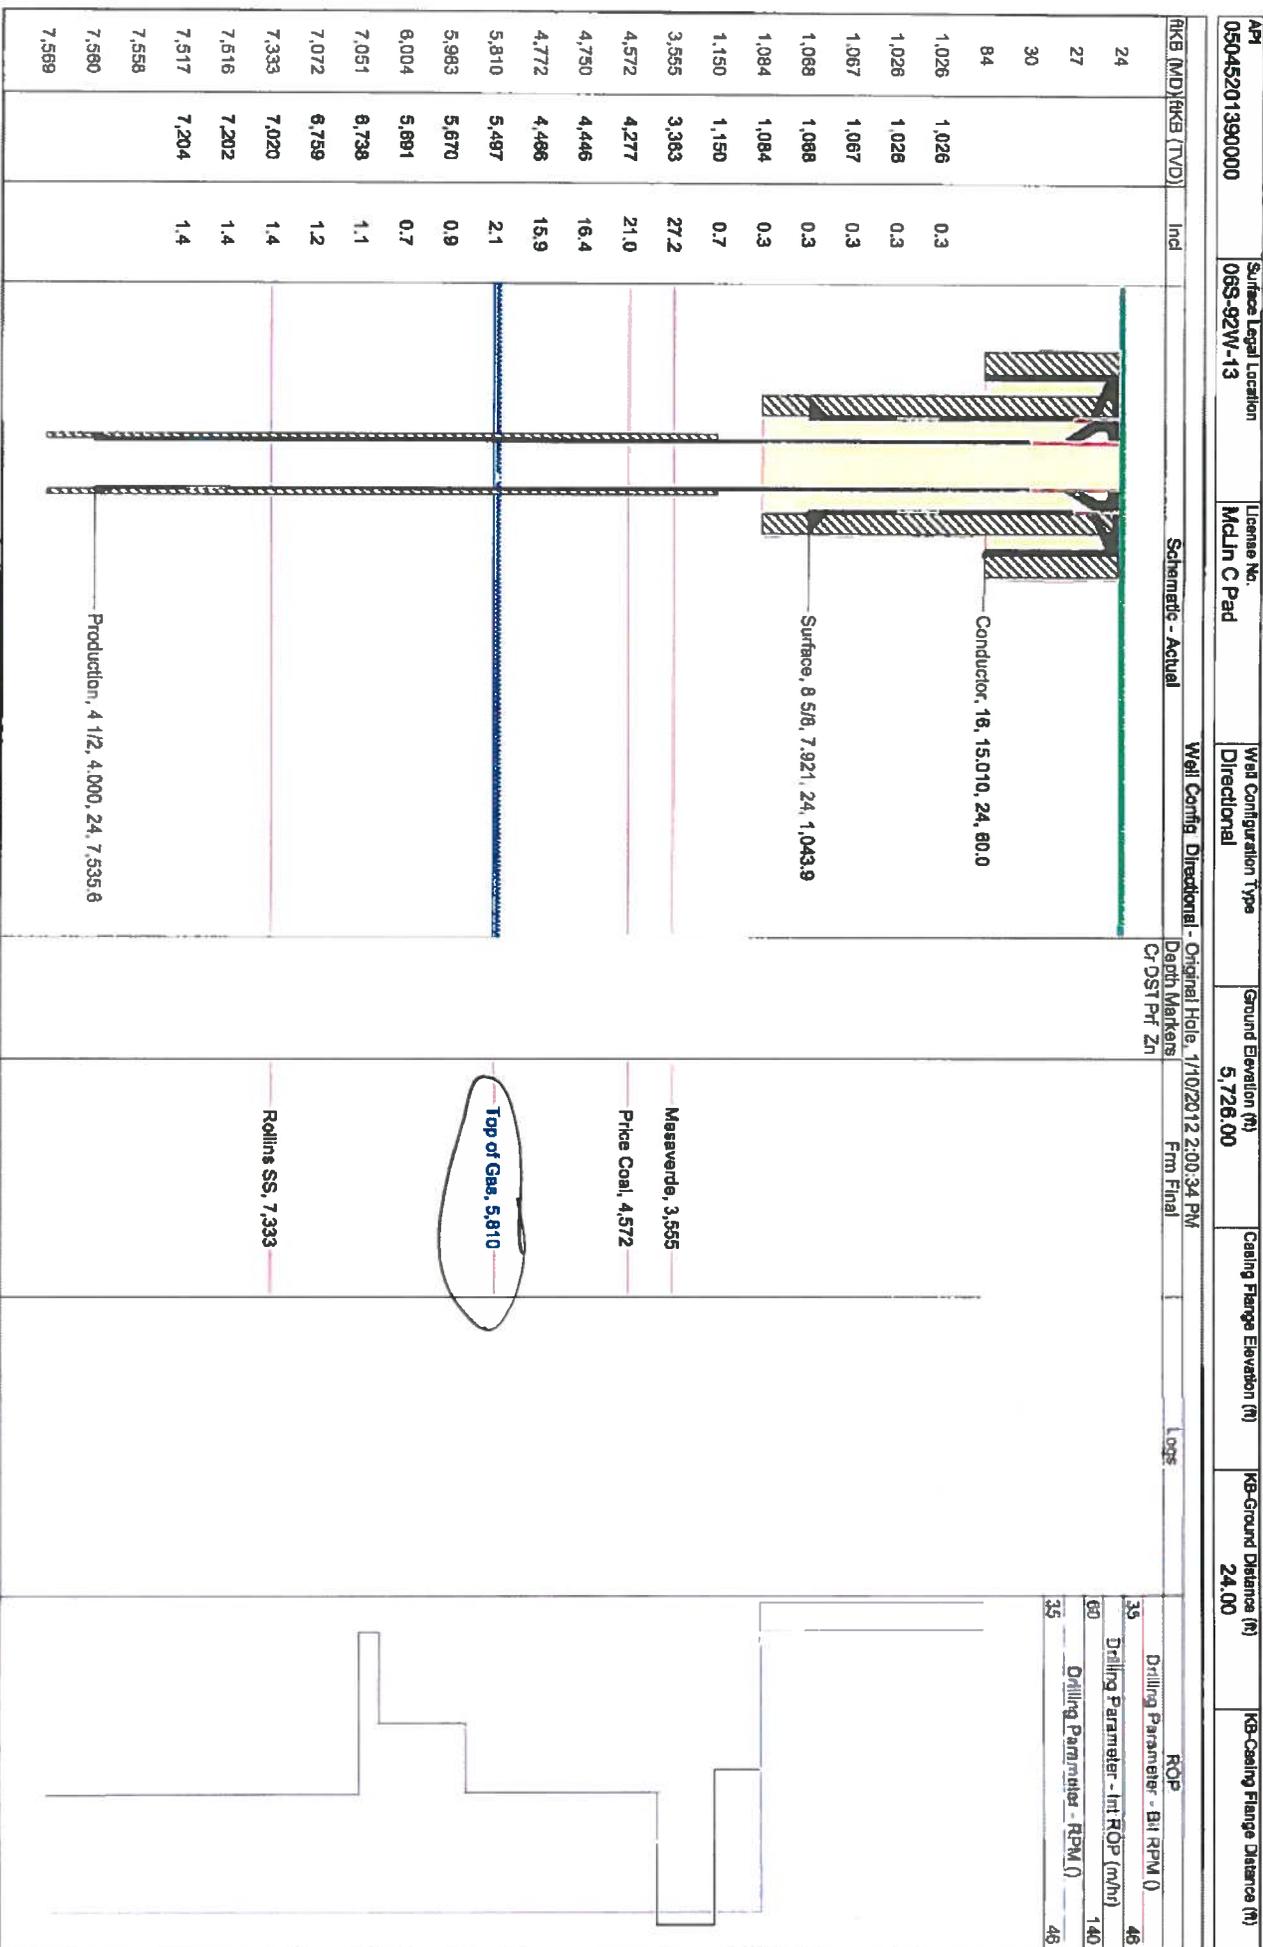

RECEIVED

JAN 10 2012

COGCC/Rifle Office