


Rex Energy Rockies LLC
Shapely #14-25H
(SWSW) Section 25-T10N-R57W
Weld County, Colorado

RECEIVED
JAN 12 2012
COGCC

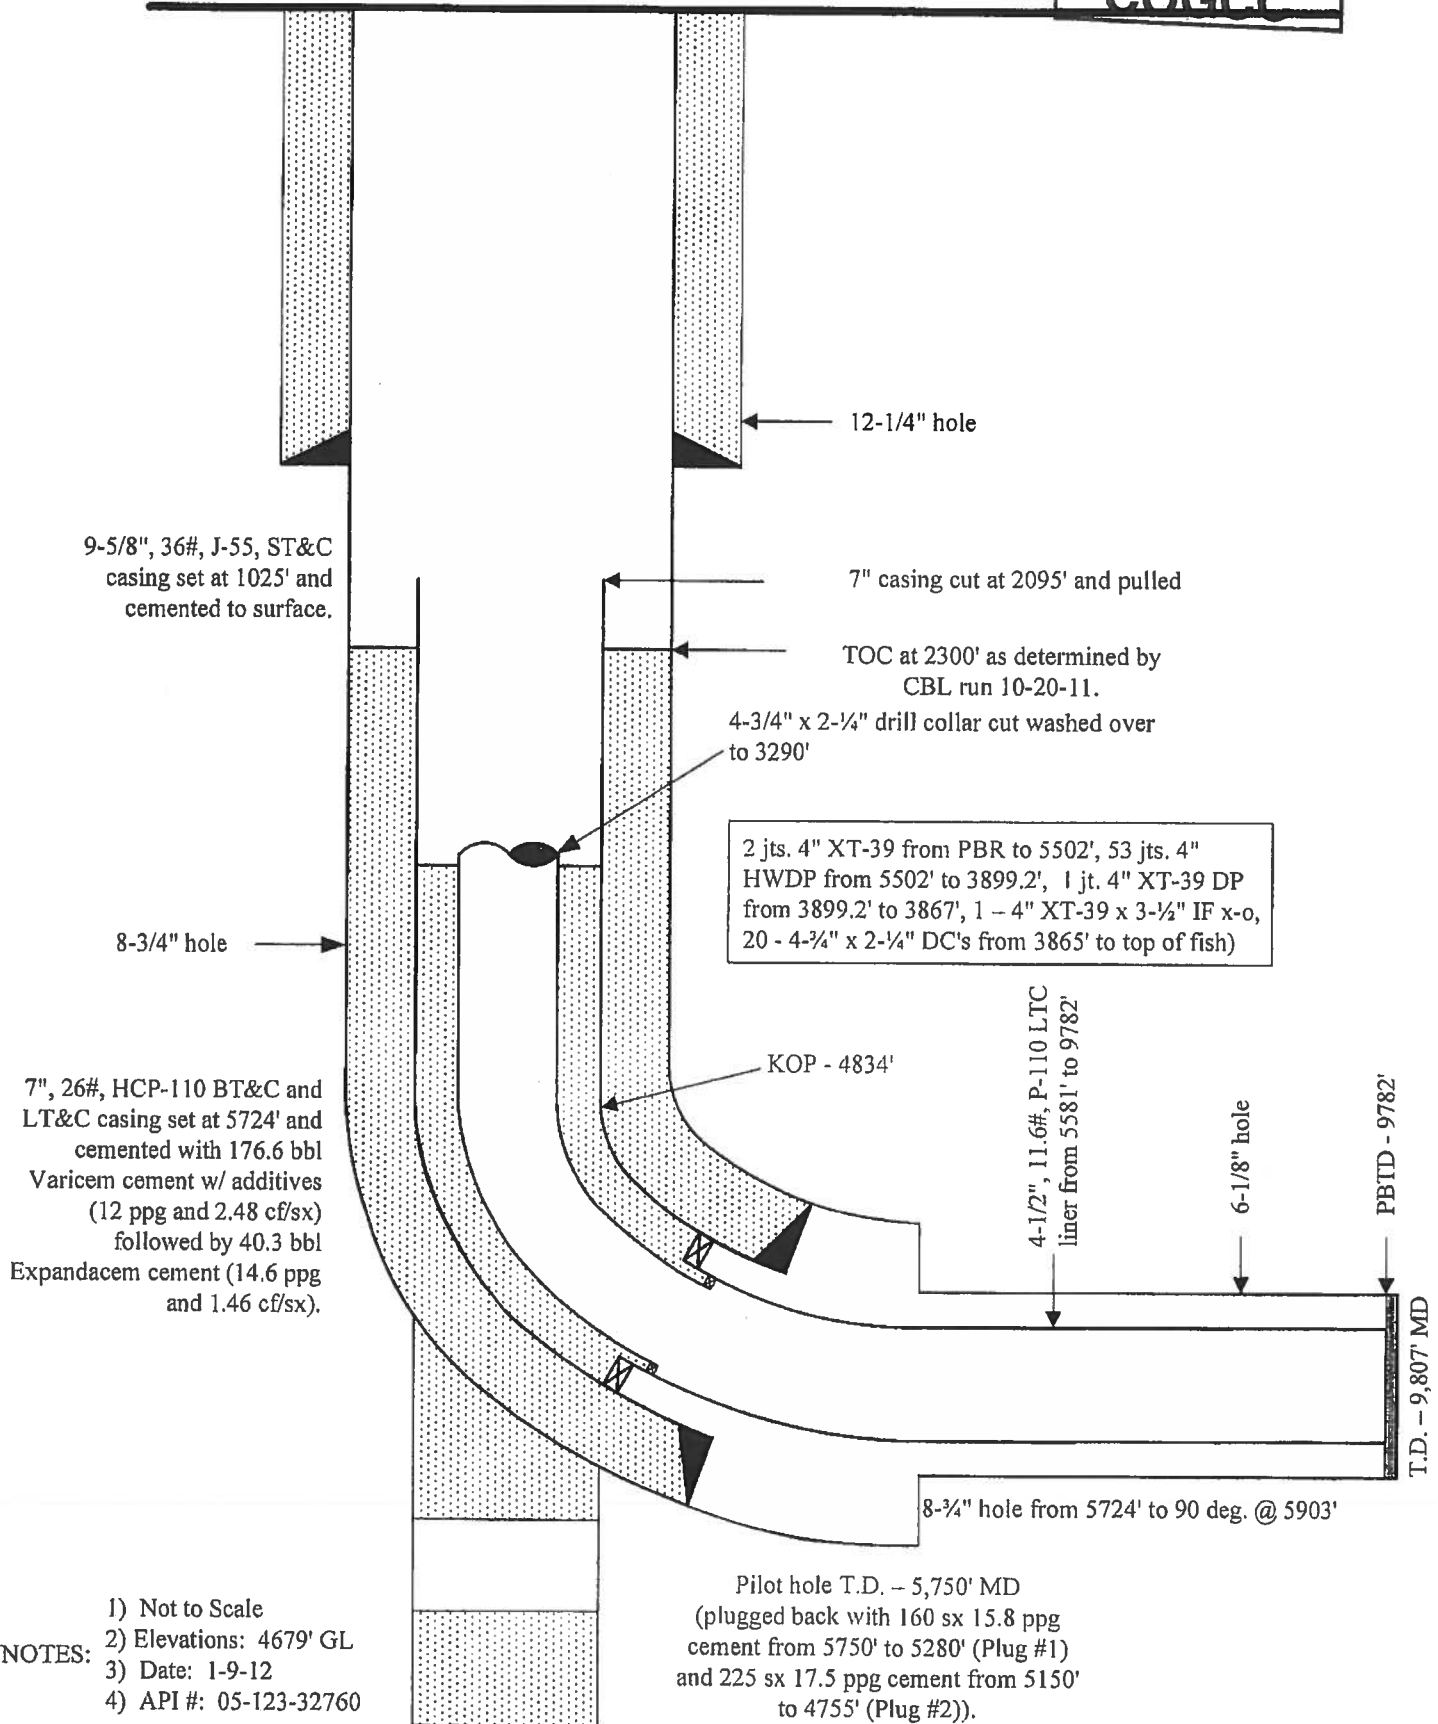

- NOTES:
- 1) Not to Scale
 - 2) Elevations: 4679' GL
 - 3) Date: 1-9-12
 - 4) API #: 05-123-32760