




Lease Name: Pratt #1-29D

Legals: SWSW – Sec. 29, T1N, R68W

County: Weld County, Colorado

API#: 05-123-32981

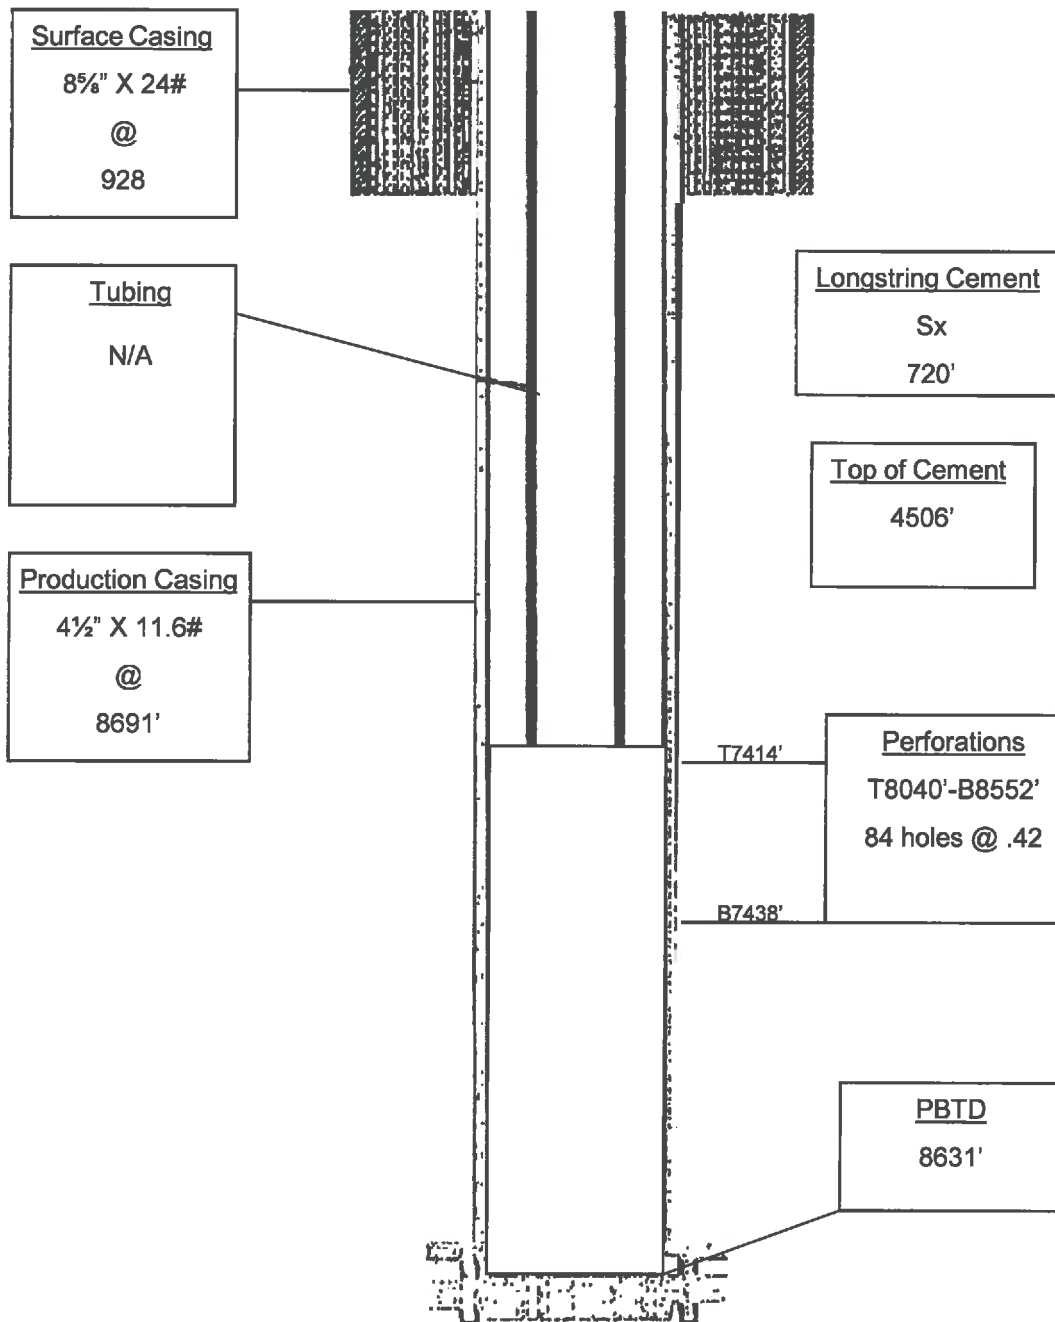

Wellbore Diagram