

Downhole Schematic for Daybreak Federal 19-8D (PJ19)



Project :South Piceance

API # :05045198980000

Surface Location :

Area :Parachute

County :


BHL :

As Of : 12/19/2011

GL :                      ft

KB to GL :            23.0 ft

KB :                      ft

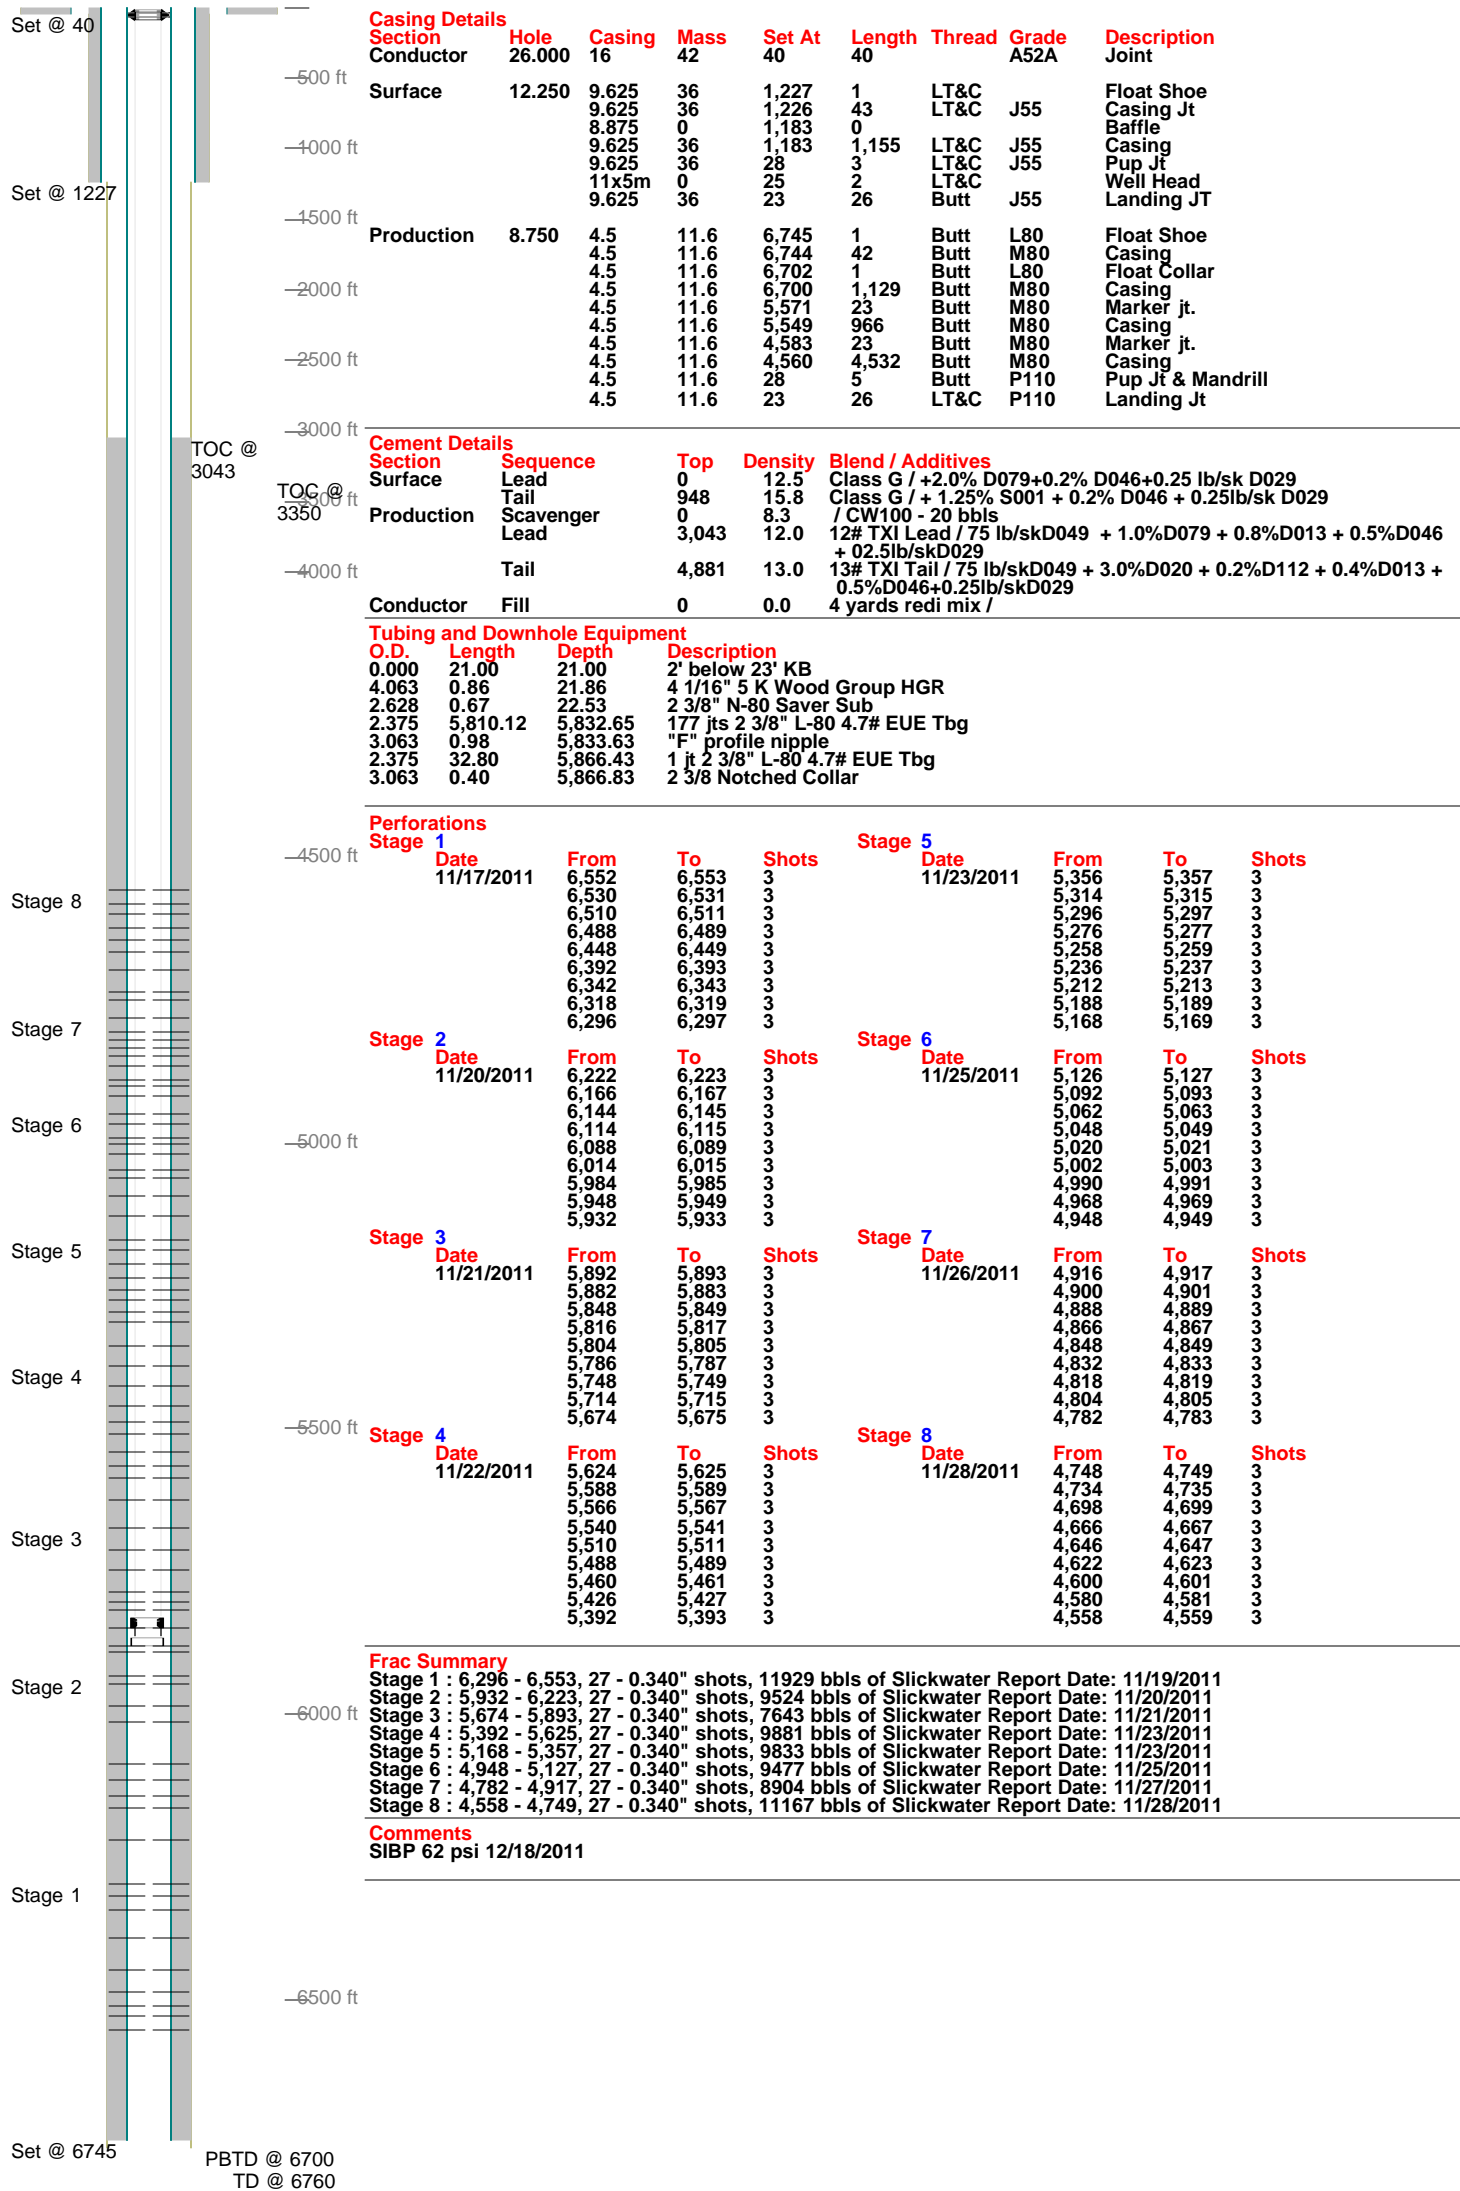

PBTD @ 6700

TD @ 6760