


# WELL LOCATION CERTIFICATE


THIS MAP DOES NOT REPRESENT A BOUNDARY SURVEY

SECTION: 9  
TOWNSHIP: 3N  
RANGE: 65W

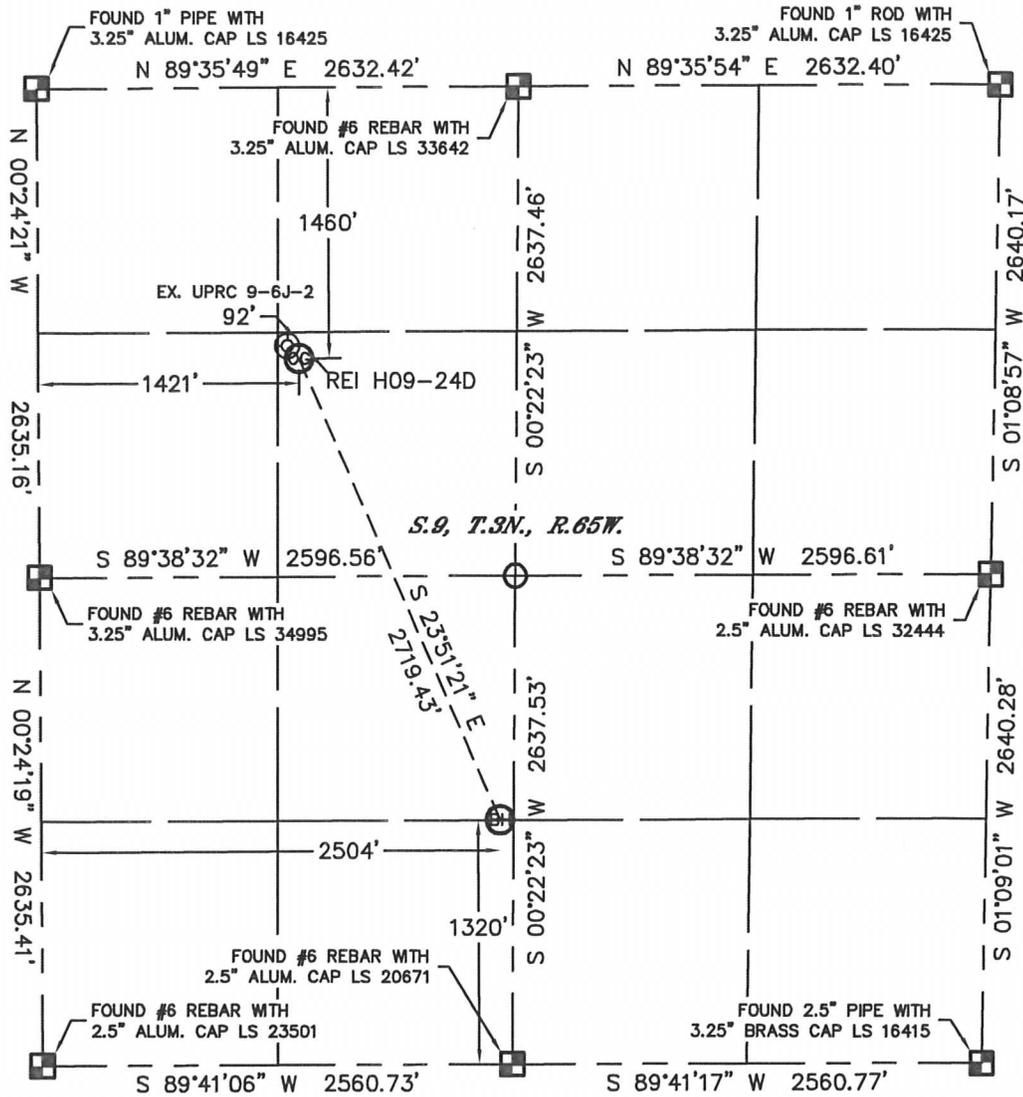

In accordance with a request from Tony Patterson with Noble Energy Inc. Lat40°, Inc. has determined the surface location of the REI H09-24D to be 1460' from the NORTH line and 1421' from the WEST line and the bottom hole to be 1320' from the SOUTH line and 2504' from the WEST line as measured at right angles from the section lines of Section 9, Township 3 North, Range 65 West of the Sixth Principal Meridian, County of Weld, State of Colorado.

I hereby state that this Well Location Certificate was prepared by me, or under my direct supervision, that the fieldwork was completed on 7/18/11, for and on behalf of Noble Energy Inc. That this is not a Land Survey Plat or an Improvement Survey Plat, and that it is not to be relied upon for establishment of fence, building, or other future improvement lines.

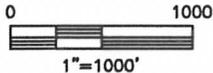

**NOTE:**

- 1) Bearings shown are Grid Bearings of the Colorado State Plane Coordinate System, North Zone, North American Datum 1983/2007. The lineal dimensions as contained herein are based upon the "U.S. Survey Foot."
- 2) Ground elevations are based on an observed GPS elevation (NAVD 1988 DATUM).
- 3) NEAREST EXISTING WELL: UPRC 9-6J-2, 92'
- 4) IMPROVEMENTS: See LOCATION DRAWING for all visible Improvements within 400' of disturbed area.
- 5) SURFACE USE: RANGELAND
- 6) INSTRUMENT OPERATOR: ADAM KELLY

**SURFACE LOCATION**

LATITUDE: 40.24312°N  
LONGITUDE: 104.67263°W  
PDOP: 1.2  
ELEV: 4829'  
1/4, 1/4: SE1/4NW1/4  
NEAREST PROPERTY LINE: 168' SW

**BOTTOM HOLE**

LATITUDE: 40.23626°N  
LONGITUDE: 104.66877°W

**NOTE**

According to Colorado law, you must commence any legal action based upon any defect in this W.L.C. within three years after you discover such defect. In no event, may any action based upon any defect in this survey be commenced more than ten years after the date of the certificate shown hereon. (13-80-105 C.R.S.)

**LEGEND**

- = ALIQUOT MONUMENT AS DESCRIBED
- = CALCULATED POSITION




Brian T. Brinkman—On behalf of Lat40°, Inc.  
Colorado Licensed Professional  
Land Surveyor No. 38175

PROJECT#: 2011172

# SITE SKETCH

REI H09-24D

SECTION: 9  
TOWNSHIP: 3N  
RANGE: 65W

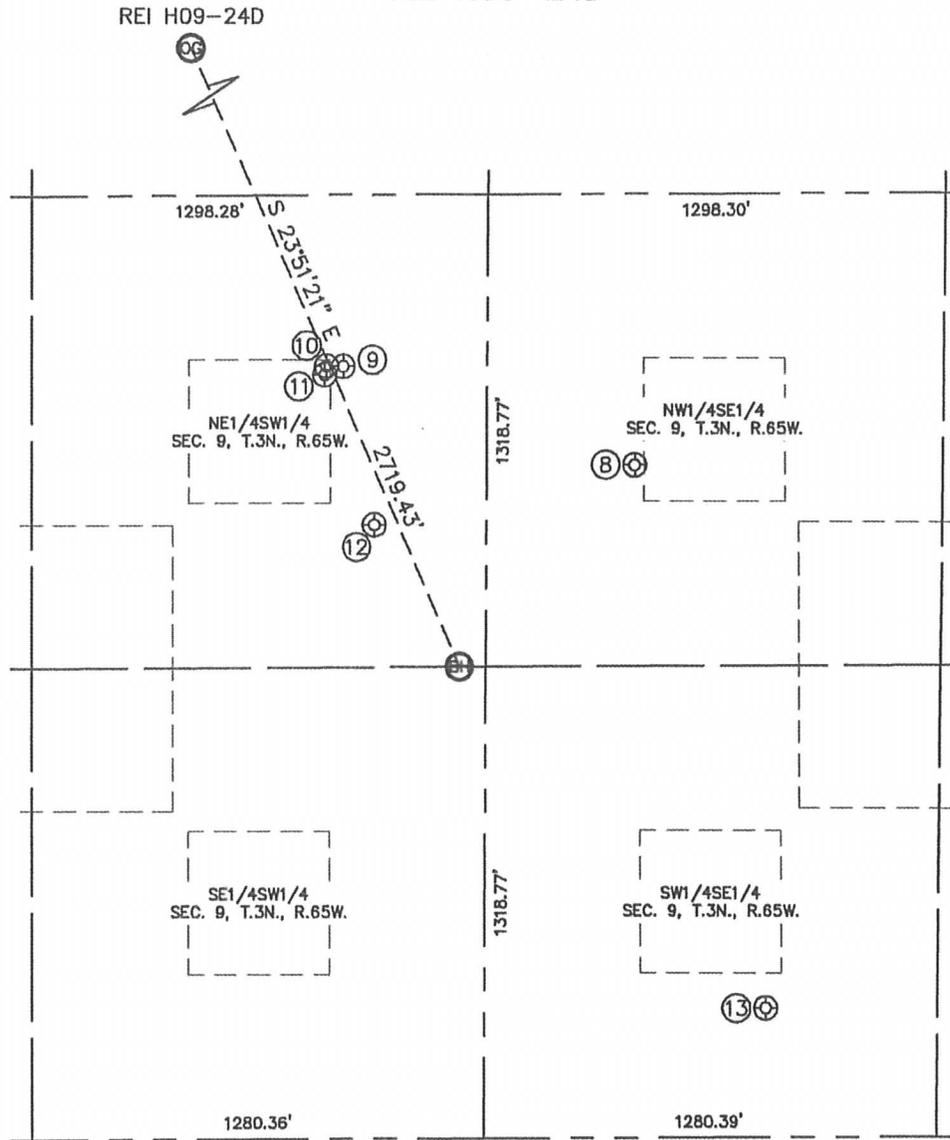

⑧  
HSR-PALLETTE 10-9  
NW1/4SE1/4  
1881' FSL  
2164' FEL  
LAT-40.23780°N  
LONG-104.66696°W  
PDOP: 1.9  
ELEV: 4820'

⑨  
UPRC 9-11J  
NE1/4SW1/4  
2159' FSL  
2178' FWL  
LAT-40.23857°N  
LONG-104.66993°W  
PDOP: 1.5  
ELEV: 4829'

⑩  
REI H09-20D  
NE1/4SW1/4  
2160' FSL  
2130' FWL  
LAT-40.23857°N  
LONG-104.67010°W  
PDOP: 1.3  
ELEV: 4829'

⑪  
UPRC H09-25D  
NE1/4SW1/4  
2138' FSL  
2125' FWL  
LAT-40.23851°N  
LONG-104.67012°W  
PDOP: 1.3  
ELEV: 4829'

⑫  
UPRC 9-14J5  
NE1/4SW1/4  
1716' FSL  
2264' FWL  
LAT-40.23735°N  
LONG-104.66963°W  
PDOP: 1.3  
ELEV: 4834'

⑬  
HSR-PERRY 15-9A  
SW1/4SE1/4  
361' FSL  
1766' FEL  
LAT-40.23362°N  
LONG-104.66569°W  
PDOP: 1.3  
ELEV: 4824'

