


# NOBLE ENERGY, INC.

## Stone 41-32

### CURRENT WELLBORE SCHEMATIC

1/11/2012

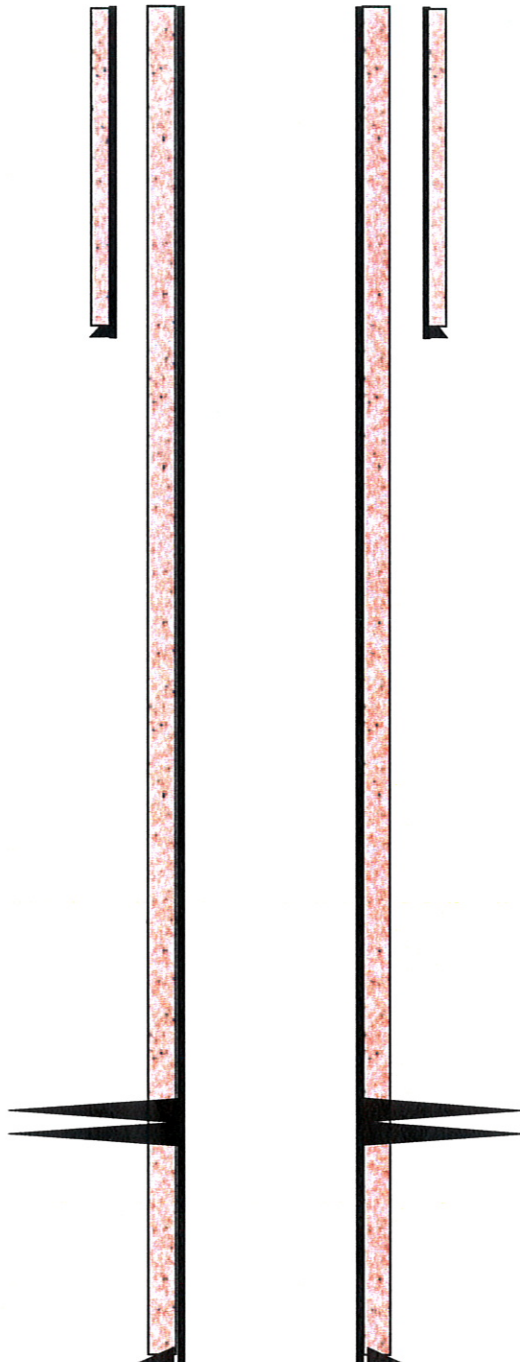

PBTD: 2564'

TD: 2640'

**Elevation:** 3837' GR, 3843' KB

**Location:** SESE Sec 32 - T2N - R45W  
40.10328 N, 102.41932 W  
Yuma County, CO

**Field:** Republican

**Spud Date:** 7/20/2006

**API:** 05-125-10043

**P&A Date:** TBD

#### Surface Casing:

7" 17#, Set @ 401' in 9-7/8" OH  
Cement w/ 153 sx, circ to surface

#### Perforations:

Niobrara Formation, 2424'-2444' (3 spf, 60 shots)

#### Production Casing:

4-1/2" 10.5#, Set @ 2620' in 6-1/4" OH  
Cement w/ 175 sx, circ to surface (CBL verified)