
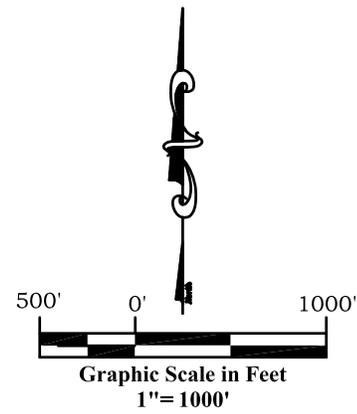


VALLEY FARMS I11

As Drilled Well Location Plat

Section 13, Township 6 South, Range 92 West

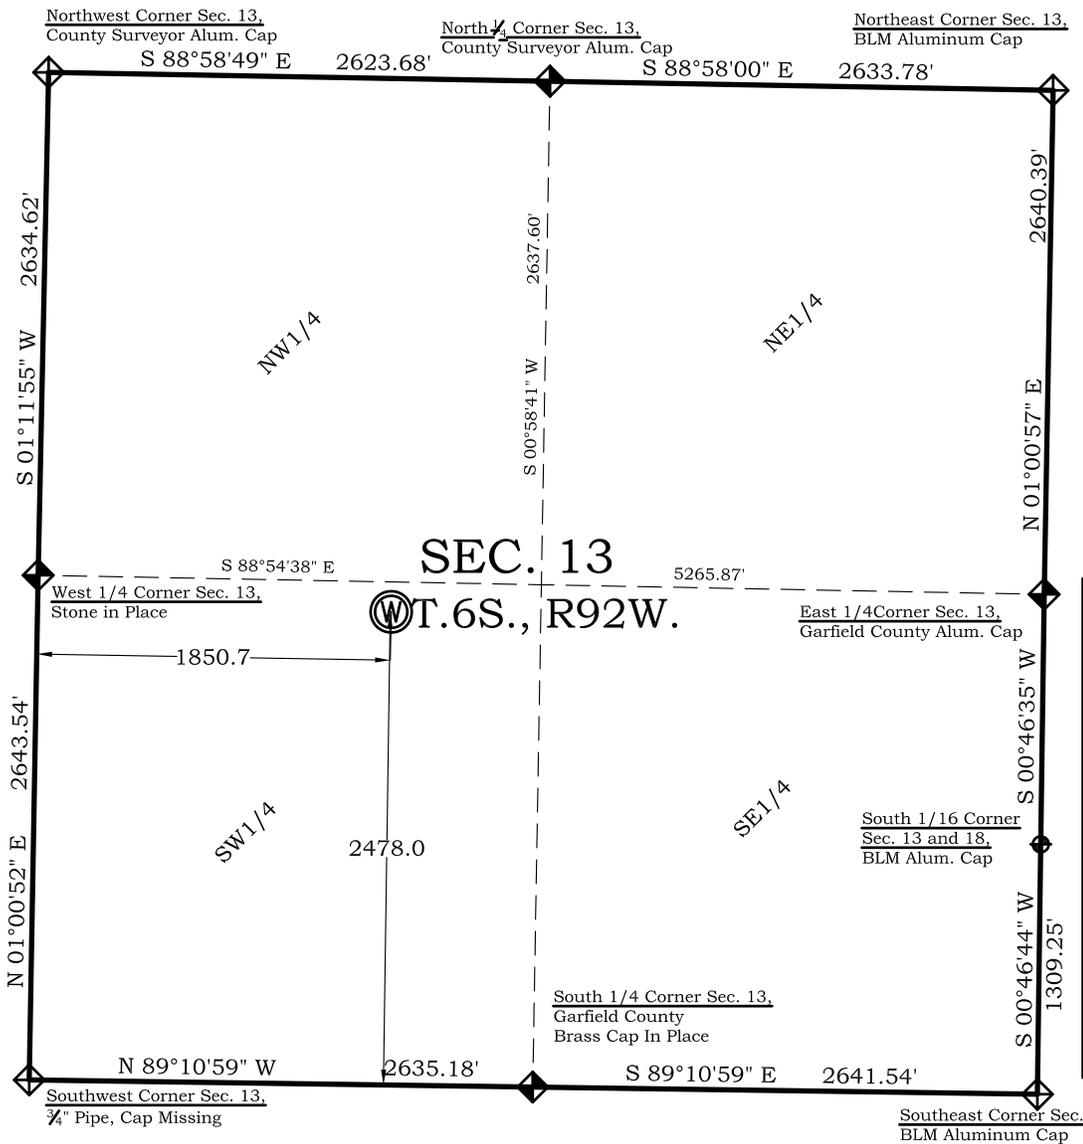

Legend

- ◊ - Field Surveyed Section Corner
- ◆ - Field Surveyed Quarter Corner
- ⊙ - Calculated Section Corner Location
- ⊕ - Field Surveyed 1/6 Corner

Surface: Valley Farms I11


2478' FSL
 1851' FWL
 Gnd El= 5655.0
NAD83
 Lat: 39.526710636°N
 Long: 107.618491527°W

NAD27
 Lat: 39.526730037°N
 Long: 107.617878079°W
 UTM 13 NORTH
NAD 1983
 NORTHING
 14365139.405
 EASTING
 902018.653

**Prepared For Antero Resources:
 As Drilled Valley Farms I11 Well Situate in The
 NE1/4SW1/4 Section 13, Township 6 South, Range 92 West
 of the 6th Principal Meridian, County of Garfield, State of
 Colorado**

SURVEYOR'S CERTIFICATE

I, SCOTT E. AIBNER, A REGISTERED LAND SURVEYOR, LICENSED UNDER THE LAWS OF THE STATE OF COLORADO DO HEREBY CERTIFY THAT THE SURVEY SHOWN HEREON WAS PREPARED BY RIVER VALLEY SURVEY, INC., FOR ANTERO RESOURCES, BY MEANS OF A TOTAL STATION UNDER MY DIRECT SUPERVISION AND HAS BEEN STAKED ON THE GROUND AS SHOWN ON THE PLAT AND THAT THIS PLAT IS A TRUE REPRESENTATION THEREOF.

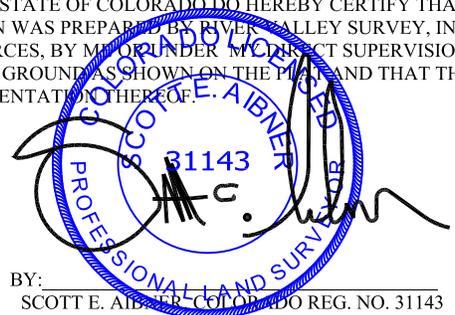

BY: _____
 SCOTT E. AIBNER, COLORADO REG. NO. 31143

Notes:

1. LATITUDE AND LONGITUDE COORDINATES ARE DIFFERENTIALLY CORRECTED AND BASED ON PUBLISHED NGS CONTROL STATION "WDP-5". SYSTEM: UTM ZONE: 13 NORTH DATUM: NAD 1983 (CONUS)
2. ELEVATIONS ARE BASED ON NAVD OF 1983.
3. ALL BOTTOM AND TOP HOLE LOCATIONS ARE MEASURED 90 DEGREES FROM SECTION LINE.
4. USGS QUADRANGLE MAP "SILT COLORADO".
5. CURRENT SURFACE LAND USE: HAY FIELD.
6. PDOP AT THE TIME OF LOCATION OF SURFACE WELL = 2.5

	River Valley Survey, Inc. 110 East 3rd. Street, Suite 213 Rifle, Colorado 81650 Ph: 970-379-7846	Project: Valley Farms IPad Proj. No. 06001-35	As Drilled Location Plat Prepared For Antero Resources
		Field Date: 12-14-11 Scale: 1"= 1000'	Situate In: NE1/4SW1/4 Section 13, T6S., R. 92 W. of the 6th P.M., Garfield County, Colorado
		Date: 01-20-12 Sheet: As Drilled	