


Well Location Map

Huron State 21-16

Section 16, T14S, R47W, 6th P.M. Cheyenne County, Colorado
1011' FNL - 2549' FWL Elev=4261'

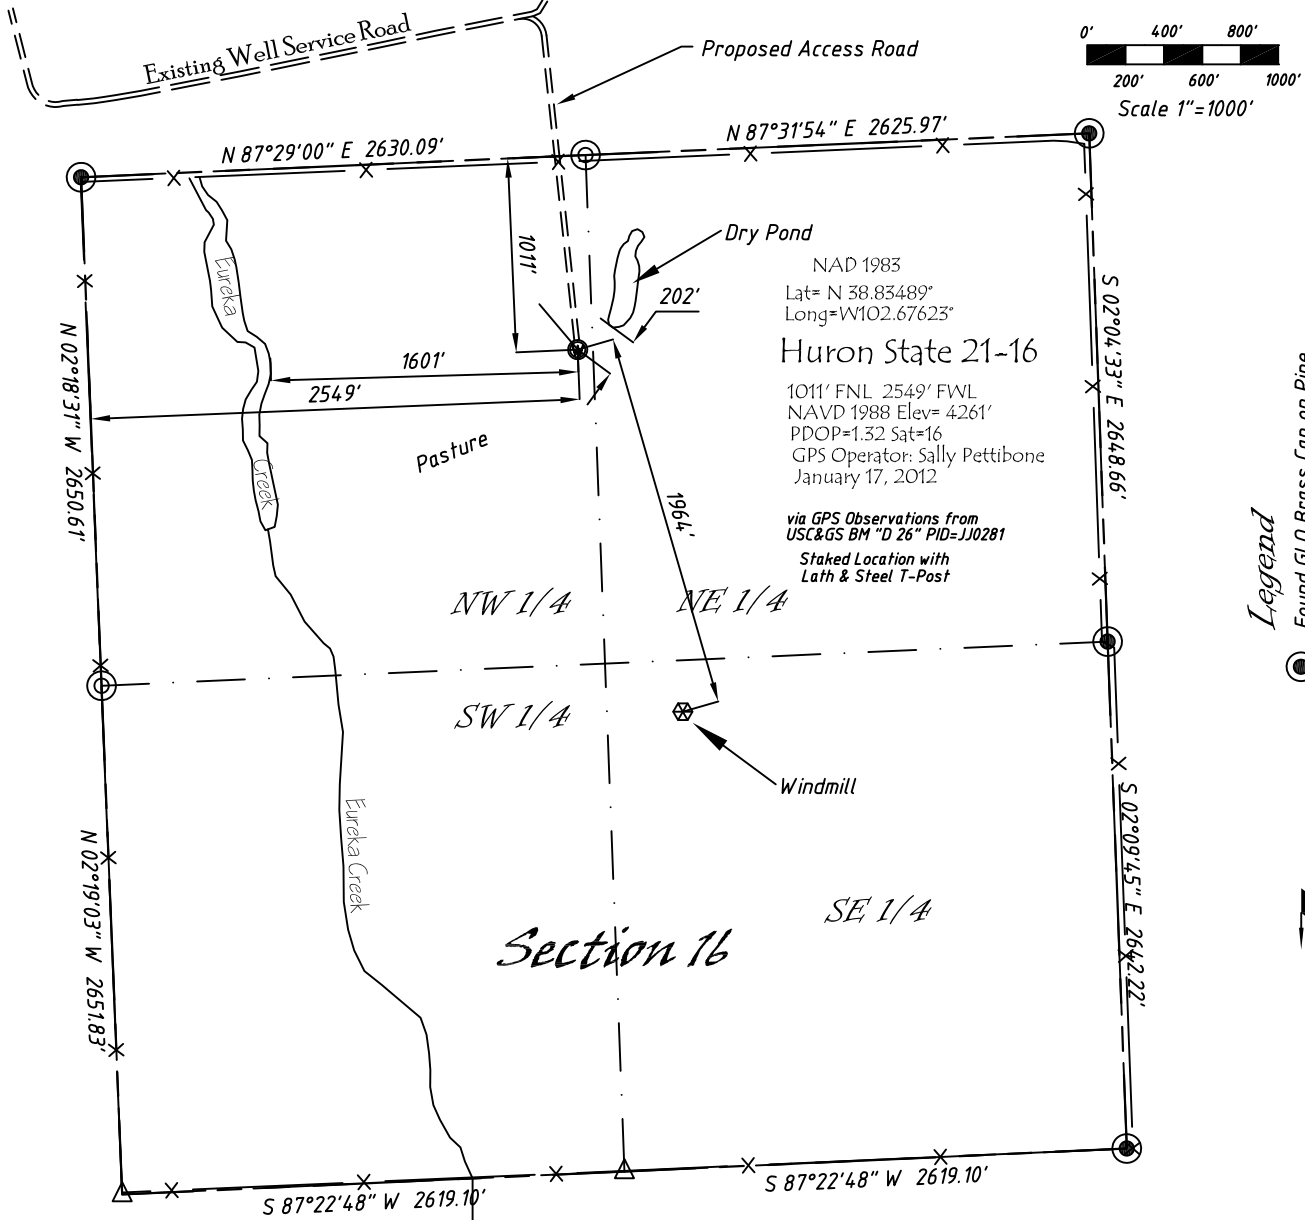

Legend

- Found GLO Brass Cap on Pipe
- Found USGLO Pipe, Set #6 Rebar & Alum Cap PLS 23902 alongside USGLO Monument
- Calculated Position from GLO Plat & Existing Monuments



Basis of Bearings

Bearings of this survey originate from GPS Observations with an observed Bearing of N 87°29'00" E along the northerly line of the NW 1/4 of Section 16, between found monuments as shown hereon.

Directions:

From the Intersection of Hwy 287 & Hwy 40 near Kit Carson, CO, Go E on Hwy 40 Approximately 4.3 miles to County Road 25, Go N on County Road 25, 4.7 miles to Rd T, Then E 0.75 Miles to Cattle Guard & Service Rd Southeast, Then SE 1 Miles to Cattle Guard. Then E through Cattle Guard 0.45 Miles to Huron 24-9. Then Southerly 1750' to Staked Location.

Notice: According to Colorado law you must commence any legal action based upon any defect in this survey within three years after you first discover such defect. In no event, may any action based upon any defect in this survey be commenced more than ten years from the date of the certification shown hereon.

Surveyor's Statement

The undersigned hereby states that this plat represents the results of a well location survey performed under my responsible charge and checking and that this is not a land survey nor land survey plat.

Copyright © 2012

Vecta Oil & Gas Ltd

DRAWN GP	DATE 1/19/12	NW 1/4, Section 16 T14S, R47W, 6th P.M. Cheyenne County, CO
FB B77 P47	EQ HiPro	
SCALE 1"=1000'	SHEET 1 of 1	PROJECT NO. 1622.024



402 Walnut
Kanorado, KS
785/399/2537