

Job: 10178 Mahalo #7

Inv # 1806

High Prairie Surveying of Kiowa, Colorado has in accordance with a request from **Jack Fincham, Wiekping Fullerton Energy** has determined the location of **Mahalo #7** to be **1980 feet FNL**, and **1980 feet FWL**, (90° off Section lines) of SECTION **29**, Township **10s**, Range **55w** of the 6th Principal Meridian, **Lincoln County**, Colorado.

Date: Staked on 1-12-12 drawn on 1-16-12.



Re: Staked by Keith Westfall

Drawn: Drawn by Elijah Frane

**Basis of Elevation Spot:** USGS BM = E 25, PID = KJ0219, H-Order = First, V-Order = First, Stability = C, P-DOP = 2.60, Sats = 9, US NAD 83 CO-C, Lat. = 39.21461, Long. = W103.60209, Elevation = 5248.17 gr. (us FT)

**Notes:** There are no apparent improvements within 400 ft of proposed well pad.  
 This drawing does not represent a monumented survey or Land Survey Plat.

**Basis of Bearing:** Bearings were determined based on the North line of Section 29 to bear S 88°16'10" W with all other bearings contained herein relative thereto.

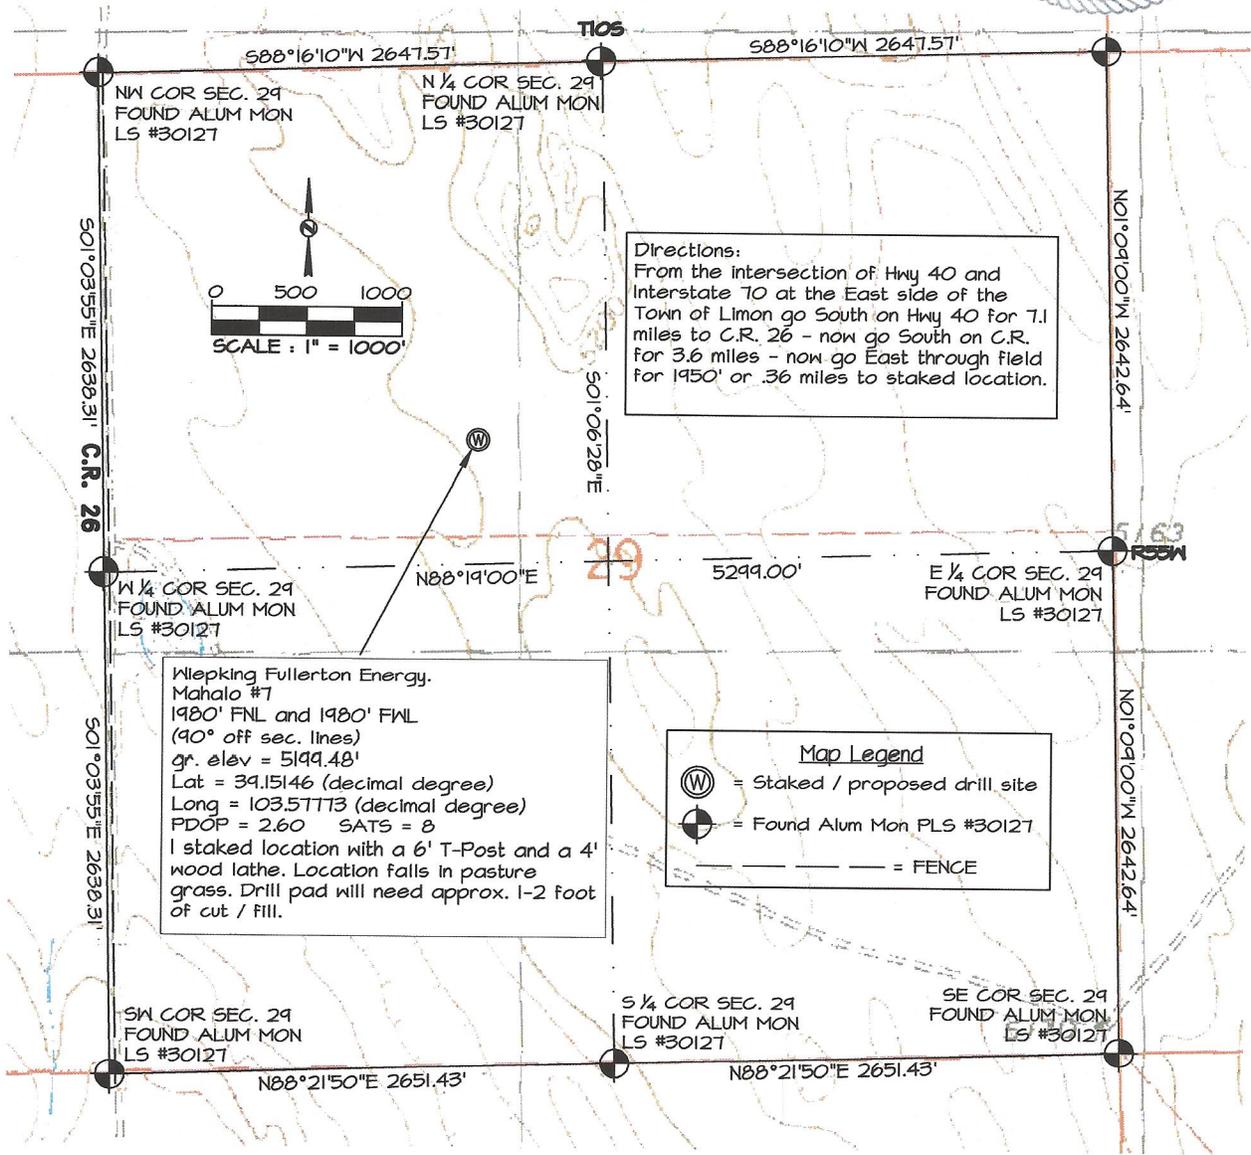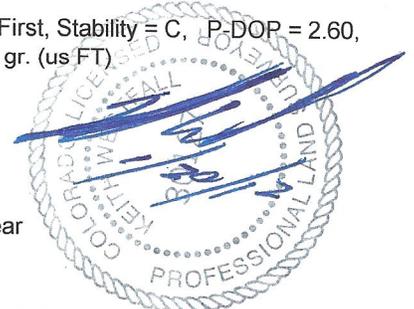

Wiekping Fullerton Energy,  
 Mahalo #7  
 1980' FNL and 1980' FWL  
 (90° off sec. lines)  
 gr. elev = 5199.48'  
 Lat = 39.15146 (decimal degree)  
 Long = 103.57173 (decimal degree)  
 PDOP = 2.60 SATS = 8  
 I staked location with a 6' T-Post and a 4' wood lathe. Location falls in pasture grass. Drill pad will need approx. 1-2 foot of cut / fill.