



1120 Lincoln Street, Suite 801, Denver, Colorado 80203 Phone: (303)894-2100 Fax: (303)894-2109

**DOCUMENT**  
**#2222465**

**SUNDRY NOTICE**

Submit original plus one copy. This form is to be used for general, technical and environmental sundry information. For proposed or completed operations, describe in full on Technical Information Page (Page 2 of this form.) Identify well or other facility by API Number or by OGCC Facility ID. Operator shall send an informational copy of all sundry notices for wells located in High Density Areas to the Local Government Designee (Rule 603b.)

**RECEIVED**  
**1/25/2012**

1. OGCC Operator Number: <u>96850</u>	4. Contact Name Karolina Blaney	Complete the Attachment Checklist  OP OGCC
2. Name of Operator: <u>WPX Energy Rocky Mountain, LLC</u>	Phone: <u>970 683 2295</u>	
3. Address: <u>1058 County Road 215</u> City: <u>Parachute</u> State: <u>CO</u> Zip: <u>81635</u>	Fax: <u>970 285 9573</u>	
5. API Number <u>05-</u>	OGCC Facility ID Number <u>279362</u>	Survey Plat
6. Well/Facility Name:	7. Well/Facility Number <u>TR 24-16-597</u>	Directional Survey
8. Location (Qtr/Sec, Twp, Rng, Meridian): <u>SESW S16 T5S R97W 6 pm</u>		Surface Eqmpt Diagram
9. County: <u>Garfield</u>	10. Field Name: <u>Trail Ridge</u>	Technical Info Page <input checked="" type="checkbox"/>
11. Federal, Indian or State Lease Number:		Other <input checked="" type="checkbox"/>

**General Notice**

<input type="checkbox"/> <b>CHANGE OF LOCATION:</b> Attach New Survey Plat (a change of surface qtr/qtr is substantive and requires a new permit)							
Change of <b>Surface</b> Footage from Exterior Section Lines:	<table border="1"> <tr> <td></td> <td>FNL/FSL</td> <td>FEL/FWL</td> </tr> <tr> <td><input type="checkbox"/></td> <td><input type="checkbox"/></td> <td><input type="checkbox"/></td> </tr> </table>		FNL/FSL	FEL/FWL	<input type="checkbox"/>	<input type="checkbox"/>	<input type="checkbox"/>
	FNL/FSL	FEL/FWL					
<input type="checkbox"/>	<input type="checkbox"/>	<input type="checkbox"/>					
Change of <b>Surface</b> Footage to Exterior Section Lines:	<input type="checkbox"/>						
Change of <b>Bottomhole</b> Footage from Exterior Section Lines:	<input type="checkbox"/>						
Change of <b>Bottomhole</b> Footage to Exterior Section Lines:	<input type="checkbox"/> attach directional survey						
Bottomhole location Qtr/Sec, Twp, Rng, Mer							
Latitude	Distance to nearest property line						
Longitude	Distance to nearest bldg, public rd, utility or RR						
Ground Elevation	Distance to nearest lease line						
	Is location in a High Density Area (rule 603b)? Yes/No <input type="checkbox"/>						
	Distance to nearest well same formation						
	Surface owner consultation date:						
<b>GPS DATA:</b>							
Date of Measurement	PDOP Reading						
	Instrument Operator's Name						
<input type="checkbox"/> <b>CHANGE SPACING UNIT</b>							
Formation	Formation Code						
Spacing order number	Unit Acreage						
	Unit configuration						
<input type="checkbox"/> <b>Remove from surface bond</b> Signed surface use agreement attached							
<input type="checkbox"/> <b>CHANGE OF OPERATOR (prior to drilling):</b>							
Effective Date:							
Plugging Bond: <input type="checkbox"/> Blanket <input type="checkbox"/> Individual							
<input type="checkbox"/> <b>CHANGE WELL NAME</b> NUMBER							
From:							
To:							
Effective Date:							
<input type="checkbox"/> <b>ABANDONED LOCATION:</b>							
Was location ever built? <input type="checkbox"/> Yes <input type="checkbox"/> No							
Is site ready for inspection? <input type="checkbox"/> Yes <input type="checkbox"/> No							
Date Ready for Inspection:							
<input type="checkbox"/> <b>NOTICE OF CONTINUED SHUT IN STATUS</b>							
Date well shut in or temporarily abandoned:							
Has Production Equipment been removed from site? <input type="checkbox"/> Yes <input type="checkbox"/> No							
MIT required if shut in longer than two years. Date of last MIT							
<input type="checkbox"/> <b>SPUD DATE:</b>							
<input type="checkbox"/> <b>REQUEST FOR CONFIDENTIAL STATUS</b> (6 mos from date casing set)							
<input type="checkbox"/> <b>SUBSEQUENT REPORT OF STAGE, SQUEEZE OR REMEDIAL CEMENT WORK</b> *submit cbl and cement job summaries							
Method used	Cementing tool setting/perf depth						
Cement volume	Cement top						
Cement bottom	Date						
<input type="checkbox"/> <b>RECLAMATION:</b> Attach technical page describing final reclamation procedures per Rule 1004.							
Final reclamation will commence on approximately	<input type="checkbox"/> Final reclamation is completed and site is ready for inspection.						

**Technical Engineering/Environmental Notice**

<input type="checkbox"/> Notice of Intent Approximate Start Date:		<input type="checkbox"/> Report of Work Done Date Work Completed:	
Details of work must be described in full on Technical Information Page (Page 2 must be submitted.)			
<input type="checkbox"/> Intent to Recomplete (submit form 2)	<input type="checkbox"/> Request to Vent or Flare	<input type="checkbox"/> E&P Waste Disposal	
<input type="checkbox"/> Change Drilling Plans	<input type="checkbox"/> Repair Well	<input type="checkbox"/> Beneficial Reuse of E&P Waste	
<input type="checkbox"/> Gross Interval Changed?	<input type="checkbox"/> Rule 502 variance requested	<input type="checkbox"/> Status Update/Change of Remediation Plans	
<input type="checkbox"/> Casing/Cementing Program Change	<input checked="" type="checkbox"/> Other: <u>Hydrostatic test results</u>	for Spills and Releases	

I hereby certify that the statements made in this form are, to the best of my knowledge, true, correct and complete.

Signed: Karolina Blaney Date: 1/24/2012 Email: Karolina.Blaney@Williams.com  
 Print Name: Karolina Blaney Title: Environmental Specialist

COGCC Approved: \_\_\_\_\_ Title: \_\_\_\_\_ Date: \_\_\_\_\_

CONDITIONS OF APPROVAL, IF ANY:

**TECHNICAL INFORMATION PAGE**



FOR OGCC USE ONLY

1. OGCC Operator Number: _____ API Number: _____
2. Name of Operator: _____ OGCC Facility ID # _____
3. Well/Facility Name: _____ Well/Facility Number: _____
4. Location (QtrQtr, Sec, Twp, Rng, Meridian): _____

This form is to be completed whenever a Sundry Notice is submitted requiring detailed report of work to be performed or completed. This form shall be transmitted within 30 days of work completed as a "subsequent" report and must accompany Form 4, page 1.

5. **DESCRIBE PROPOSED OR COMPLETED OPERATIONS**

Attachment A  
Hydrostatic Test Results

# Hydrostatic Pit Testing

## Data Collection & Computation Form

Fox Engineering Solutions



**Pit Owner:** Williams Production RMT Company  
**Pit Name:** TR 24-16-597  
**COGCC Facility No.** 279362  
**Pit Location:** SE 1/4 SW 1/4 Sec 16, T5S, R97W, 6th P.M.  
 Latitude: N 39.6091° Longitude: W108.2859° NAD83  
**Reported Liner:** 24mil Polypropylene  
**Approximate Elevation:**  
**Test Conducted By:** David Fox, Fox Engineering Solutions

<b>Test Initiation:</b>		<b>Test Termination:</b>	
Date:	10/10/2011	Date:	10/13/2011
Time:	11:30 AM	Time:	11:30 AM
Total Duration:	72 hours		

	<u>Length</u>	<u>Width</u>	<u>Area</u>	<u>Comments</u>
Tributary Pit Liner Surface Area (ft <sup>2</sup> ):	-	-	4,702 ft. <sup>2</sup>	Surveyed by Bookcliff Survey
Initial Pit Water Surface Area:	-	-	2,704 ft. <sup>2</sup>	Surveyed by Bookcliff Survey
Final Pit Water Surface Area:	-	-	2,704 ft. <sup>2</sup>	Surveyed by Bookcliff Survey
Average Pit Surface Area:			2704 ft. <sup>2</sup>	

Initial Pit Fluid Level:		997.85 ft.
Final Pit Fluid Level:		<u>997.56</u> ft
Difference		0.29 ft or
Est. Fluid Depth:	9 ft.	3.48 inches

Evaporation Pan Installed: Yes	Location: South side of pit	Measured Pan Evaporation:	0.25 inches
		during Test Duration	
		Evaporation w/ Pan Coeff. 0.72	0.18 inches

Rain Gauge Installed: Yes	Location: South side of pit	Recorded Precipitation:	0.07 inches
		Equiv. 72-Hour Precip. Inflow:	0.05 inches

Other Inflow/Outflow:	Inflow (gal)	0	Equivalent Inflow:	0.00 inches
	Outflow (gal)	0	Equivalent Outflow:	0.00 inches

Calculated Fluid Level Change in Inches:	(+ indicates fluid level increased)	
	(Precipitation - Pan Evaporation + Inflows - Outflows)	-0.19 inches
	(Precipitation - 72% Pan Evaporation + Inflows - Outflows)	-0.13 inches

Measure Change in Inches:	(+ indicates fluid level increased)	-3.48 inches
---------------------------	-------------------------------------	--------------

Difference between Calculated and Measured Pit Fluid Level:	(With Pan Evaporation)	-3.30 inches
	(With 72% Pan Evaporation)	-3.35 inches

**Summary: Recommend Re-test. Fluid level drop in pit exceeded evaporation.**


Weather: Cool 40 - 75° temperatures with precipitation event.

**Liner and Pit Condition:** Produced water fluid level at approximate 9 ft depth. Visible portion of liner, approximately the top 5-6 ft., had no apparent delamination or seam failures with the exception of one 2" x 3" hole in liner noted at rim of north side.

**Comments:** Bookcliff Survey utilized a Trimble Total Station for required area and elevation measurements. Williams staff indicated that no fluids were transferred from or to the pit during the duration of the test. Guard at site at beginning of test. No guard present at test completion.

# HYDROTEST EXHIBIT

## TRAIL RIDGE 24-16-597

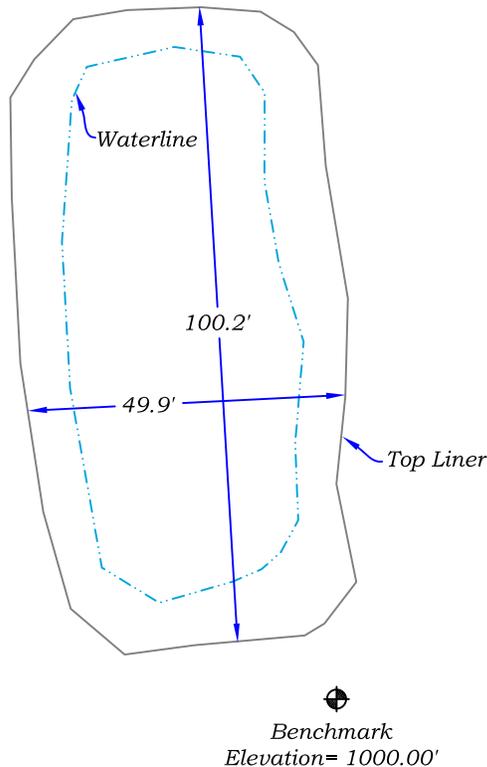

SCALE: 1" = 30'

### TRAIL RIDGE 24-16-597 PIT DETAILS

TEST @ 11:30A.M.


TOP WATER ELEV. (OCTOBER 10, 2011)= 997.85'  
TOP WATER ELEV. (OCTOBER 13, 2011)= 997.56'  
TOP WATER SURFACE AREA (OCTOBER 10, 2011)= 2,704 sq. ft.

TOP OF LINER SURFACE AREA = 4,702 sq. ft.

### TRAIL RIDGE 24-16-597 PIT LOCATION

SECTION 16,  
TOWNSHIP 5 SOUTH,  
RANGE 97 WEST OF THE SIXTH P.M.

136 East Third Street  
Rifle, Colorado 81650  
Ph. (970) 625-1330  
Fax (970) 625-2773

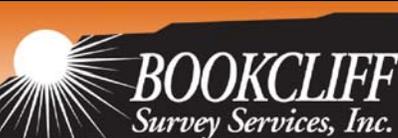

Fox Engineering Solutions  
670 Canyon Creek Dr.  
Grand Junction, CO 81503

TRAIL RIDGE  
24-16-597

DATE: 10/13/11  
SHEET: 1 OF 1  
PROJECT: HYDROTEST  
DFT: SRB

# Hydrostatic Testing Procedures for COGCC Earthen Pits

Version 5.0



The purpose for hydrostatic testing earthen pits is to comply with COGCC approval conditions for verifying the fluid holding integrity of the pit lining system. These procedures are specific to existing or active earthen pits holding oil and gas related fluids including, but not limited to, produced water. During testing, the pit shall have fluid level as high as practical, without encroaching into the 2 ft. freeboard, and the test shall be conducted for a minimum of 72 hours, if practical. Visible portions of the liner, including the anchor trench and seams, shall be inspected for defects. The test shall be scheduled and coordinated with personnel to ensure that oil and gas activities do not interfere with the test. Testing procedures may be subject to changes as dictated by field and climatic factors. All personnel involved with testing, while onsite, shall comply with their respective EH&S requirements.

- If practical, a sign shall be placed in a conspicuous location during the test stating "Hydrostatic Testing in Progress, Pit Closed to All Water Hauling Activities". Contact information shall also be placed on the sign.
- A semi-permanent datum elevation point shall be established at the pit location. The surface area of the water surface and the surface area of the liner area, tributary to the pit shall be measured. The date and time of each measurement shall be documented.
- The pit fluid level; fluid surface area; and the lined surface area, tributary to the pit, shall be measured and recorded at the beginning of the test. The pit fluid level shall be measured again at the end of the test. A survey grade total station shall be utilized for accuracy to capture this information. The date and time of measurements shall be documented.
- A 4" diameter official rain gauge with funnel inlet shall be installed at the pit site. Precipitation shall be recorded for the duration of the hydrostatic test.
- Pan Evaporation shall be measured during the duration of the test following the procedures established by the National Weather Service – NOAA in the document entitled "National Weather Service - Observing Handbook No. 2, dated July 1989. A Class A evaporation pan shall be placed at the site, or as near as practical, with evaporation measured per established procedures.
- For the duration of the test, all inflows and outflows, such as truck and piped transfers, shall cease. If the cessation of inflows and outflows is not practical, all pit inflows and outflows shall be accurately metered and documented during the test. 24-hour surveillance monitoring may be warranted.
- If no precipitation has occurred during the test, compare the change in the pit fluid level with the recorded pan evaporation.
- If precipitation has occurred during the test, precipitation falling onto tributary portions of the liner, outside of the fluid surface area, must be added as an inflow to the pit and converted into inches of depth over the fluid surface area.
- The calculated change in pit level during the test is:  $\Delta S = P + I - O - E$  (all measurements converted to inches)

Where:  $\Delta S$  = Change in pit storage  
P = Precipitation Inflow  
I = Measured Inflows  
O = Measured Outflows  
E = Evaporation

- The measured change in the pit fluid level shall be compared to the calculated change, utilizing precipitation and evaporation data, in the pit fluid level during the test duration. The test procedures and results will be reviewed and analyzed for discrepancies. If the test results indicate integrity issues with the lining system, the test will be repeated.