

Private Alum. Cap
Buried 0.6' Below
Gravel Road
Lat: 40.988528°
Long: 104.315131°

T12N, R62W, 6th P.M.

2010 Alum. Cap
Buried 0.5' Below
Gravel Road
Lat: 40.988300°
Long: 104.296439°

EOG RESOURCES, INC.

Well location, (AS-BUILT) RANDALL CREEK
#13-27H, located as shown in the NW 1/4 NE
1/4 of Section 27, T12N, R62W, 6th P.M., Weld
County, Colorado.

BASIS OF ELEVATION

SPOT ELEVATION AT THE NORTHEAST CORNER OF SECTION
1, T11N, R63W, 6th P.M. TAKEN FROM THE HEREFORD,
QUADRANGLE, COLORADO, WELD COUNTY, 7.5 MINUTE QUAD
(TOPOGRAPHIC MAP) PUBLISHED BY THE UNITED STATES
DEPARTMENT OF THE INTERIOR, GEOLOGICAL SURVEY. SAID
ELEVATION IS MARKED AS BEING 5352 FEET.

BASIS OF BEARINGS

BASIS OF BEARINGS IS A G.P.S. OBSERVATION.


N01°09'48"E - 5508.80' (Meas.)

(AS-BUILT) RANDALL CREEK #13-27H
Elev. Graded Ground = 5317'

LINE TABLE		
LINE	DIRECTION	LENGTH
L1	S82°29'06"W	2486.69'

27

S00°08'21"W - 5397.54' (Meas.)

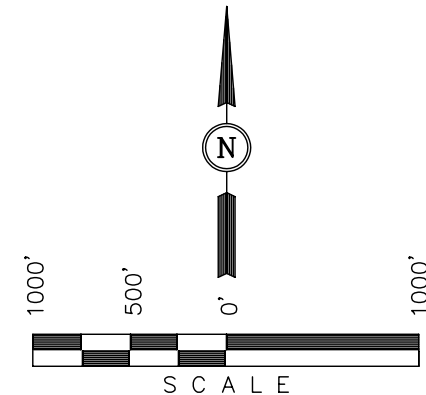

CERTIFICATE

THIS IS TO CERTIFY THAT THE ABOVE PLAT WAS PREPARED FROM
FIELD NOTES OF ACTUAL SURVEYS MADE BY ME OR UNDER MY
SUPERVISION AND THAT THE SAME ARE TRUE AND CORRECT TO THE
BEST OF MY KNOWLEDGE AND BELIEF.

REGISTERED LAND SURVEYOR
REGISTRATION NO. 17492
STATE OF COLORADO
01-03-12

2000 Alum. Cap
Buried 0.5' Below
Highway, LS 22093
Lat: 40.973489°
Long: 104.296503°

True Position

WC S00°39'52"W - 250.00' (G.L.O.)
Private Alum. Cap
Lat: 40.972731°
Long: 104.315558°

S89°40'05"W - 5260.36' (Meas.)

PDOP = 1.7

LEGEND:

- └─┘ = 90° SYMBOL
- = PROPOSED WELL HEAD.
- ▲ = SECTION CORNERS LOCATED.

NAD 83 (AS-BUILT SURFACE LOCATION)	
LATITUDE	= 40°59'14.68" (40.987411)
LONGITUDE	= 104°18'19.32" (104.305367)
NAD 27 (AS-BUILT SURFACE LOCATION)	
LATITUDE	= 40°59'14.74" (40.987428)
LONGITUDE	= 104°18'17.49" (104.304858)
STATE PLANE NAD 83	
N: 1604791.69	E: 3329824.63
STATE PLANE NAD 27	
N: 604789.14	E: 2329974.04

UINTAH ENGINEERING & LAND SURVEYING			
85 SOUTH 200 EAST - VERNAL, UTAH 84078			
(435) 789-1017			
SCALE 1" = 1000'		DATE SURVEYED: 12-22-11	DATE DRAWN: 01-03-12
PARTY J.H. C.M. J.I.		REFERENCES G.L.O. PLAT	
WEATHER COLD		FILE EOG RESOURCES, INC.	