




**DRILLING COMPANY, INC.**  
**WICHITA, KANSAS**

**Wellbore Diagram**

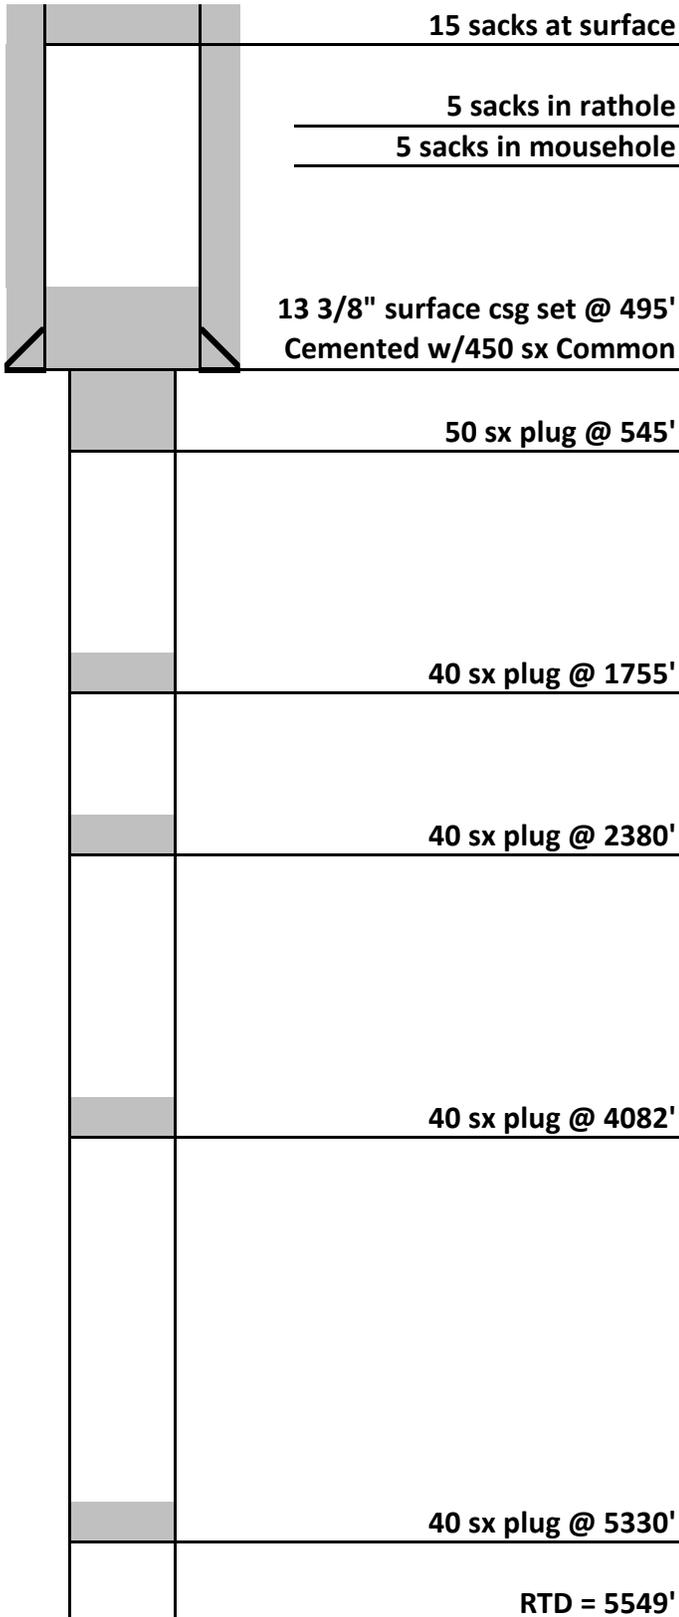

Date: 2/3/2012

Well Name: APC-Mako #1-19

Location: 660' FNL & 660' FWL  
Lot 1, Section 19-14S-44W

County: Cheyenne

State: Colorado

API: 05-017-07704-00

Surface Casing: 13 3/8" set @ 495'  
 Cemented with: 450 sx Common

Total Depth: 5549'

Spud Date: 12/26/2011

P&A Date: 1/10/2012

LOG TOPS	
<u>FORMATION</u>	<u>DEPTH</u>
Shawnee	4132
Heebner Shale	4314
Lansing	4358
Marmaton	4718
Ft. Scott	4784
Cherokee Shale	4846
Atoka Shale	4992
Morrow Shale	5122
Keyes	5238
Mississippian	5312