




PROPOSED SPACING UNIT

THIS MAP DOES NOT REPRESENT A BOUNDARY SURVEY


SECTION: 32
TOWNSHIP: 5N
RANGE: 63W

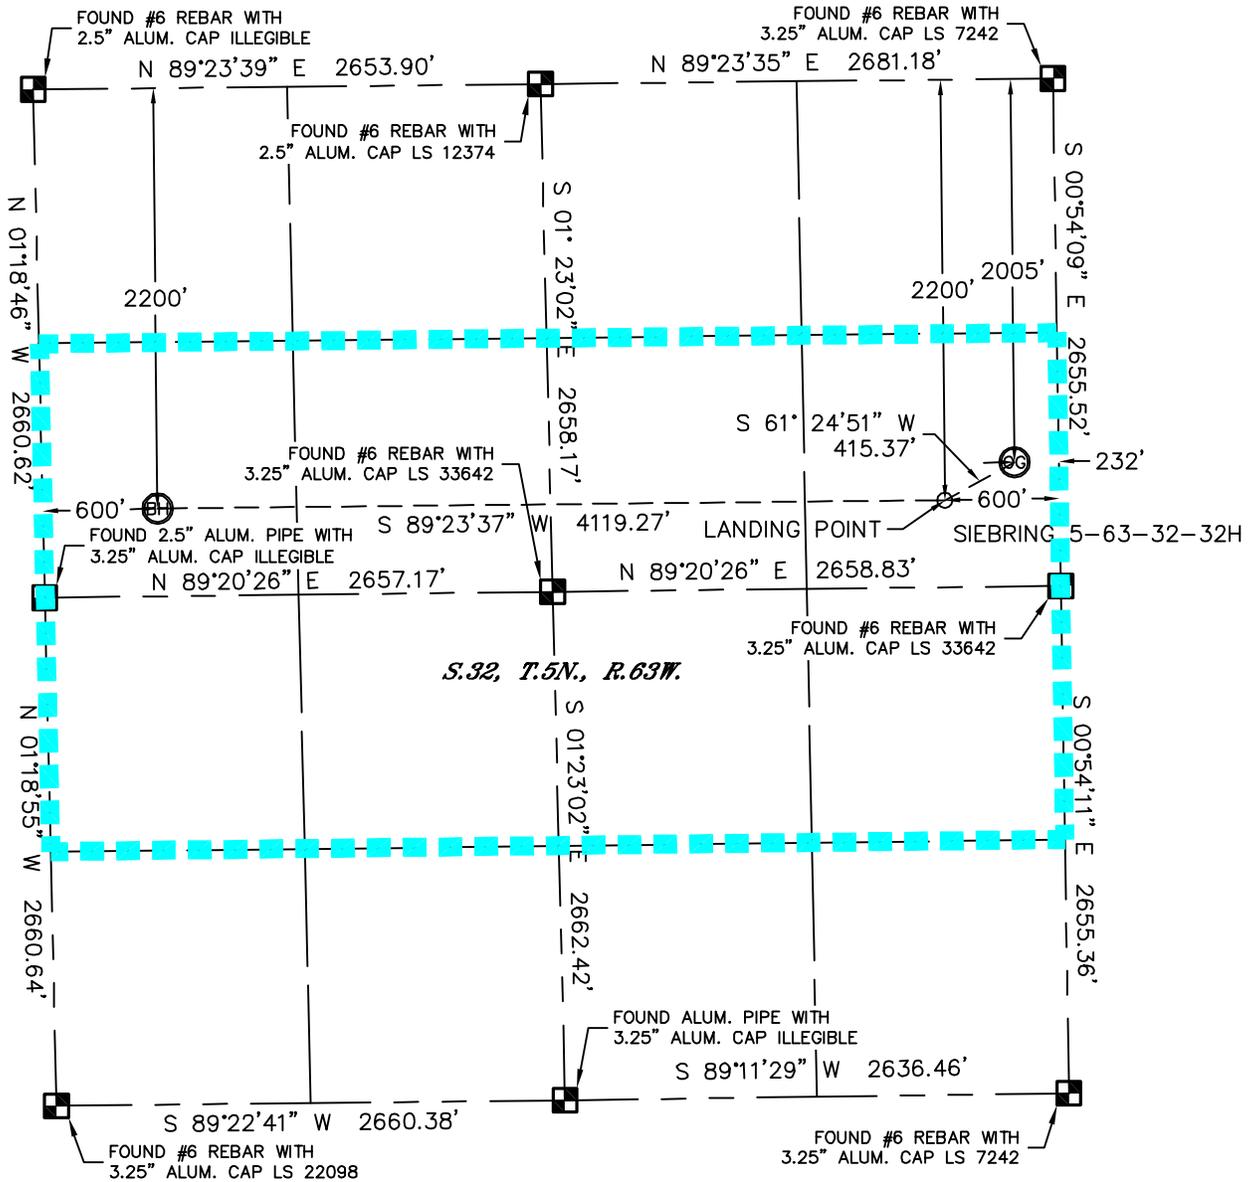

S.32, T.5N., R.63W.

In accordance with a request from Glenn Berglund with BILL BARRETT CORPORATION Lat40°, Inc. has determined the surface location of the SIEBRING 5-63-32-32H to be 2005' from the NORTH line and 232' from the EAST line and the bottom hole to be 2200' from the NORTH line and 600' from the WEST line as measured at right angles from the section lines of Section 32, Township 5 North, Range 63 West of the Sixth Principal Meridian, County of Weld, State of Colorado.

I hereby state that this Well Location Certificate was prepared by me, or under my direct supervision, that the fieldwork was completed on 10/25/11, for and on behalf of BILL BARRETT CORPORATION. That this is not a Land Survey Plat or an Improvement Survey Plat, and that it is not to be relied upon for establishment of fence, building, or other future improvement lines.

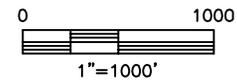

NOTE:

- 1) Bearings shown are Grid Bearings of the Colorado State Plane Coordinate System, North Zone, North American Datum 1983/2007. The lineal dimensions as contained herein are based upon the "U.S. Survey Foot."
- 2) Ground elevations are based on an observed GPS elevation (NAVD 1988 DATUM).
- 3) IMPROVEMENTS: See LOCATION DRAWING for all visible improvements within 400' of disturbed area.
- 4) SURFACE USE: CROP LAND
- 5) INSTRUMENT OPERATOR: ADAM KELLY

SURFACE LOCATION

LAT: 40.35776°N (40°21'27.9"N)
 LONG: 104.45126°W (104°27'04.5"W)
 PDOP: 1.5
 ELEV: 4569'
 1/4, 1/4: SE1/4NE1/4
 NEAREST PROPERTY LINE: 232' E

BOTTOM HOLE

LAT: 40.35724°N (40°21'26.1"N)
 LONG: 104.46735°W (104°28'02.5"W)

LANDING POINT

LAT: 40.35723°N (40°21'26.0"N)
 LONG: 104.45258°W (104°27'09.3"W)

NOTE

According to Colorado law, you must commence any legal action based upon any defect in this W.L.C. within three years after you discover such defect. In no event, may any action based upon any defect in this survey be commenced more than ten years after the date of the certificate shown hereon. (13-80-105 C.R.S.)

LEGEND

-  = ALIQUOT MONUMENT AS DESCRIBED
-  = CALCULATED POSITION

DATE: 1/26/12
 PROJECT#: 2011312