



Physical Address: 401 Arapahoe St.  
 Mail to: Box 384 Kiowa, CO 80117  
 Ph. 303-621-8672 - Fax 303-621-2717  
 www.highprairiesurvey.com

Job: 10177 Napali #6

Inv # 1802

High Prairie Surveying of Kiowa, Colorado has in accordance with a request from **Jack Fincham, Wiepking Fullerton Energy** has determined the location of **Napali #6** to be **1980 feet FSL**, and **660 feet FWL**, (90° off Section lines) of **SECTION 17**, Township **10s**, Range **55w** of the 6th Principal Meridian, **Lincoln County**, Colorado.

Date: Staked on 1-12-12. drawn on 1-13-12.


Re: Staked by Keith Westfall

Drawn: Drawn by Elijah Frane

**Basis of Elevation Spot:** USGS BM = E 25, PID = KJ0219, H-Order = First, V-Order = First, Stability = C, P-DOP = 2.70, Sats = 8, US NAD 83 CO-C, Lat. = 39.21461, Long. = W103.60209, Elevation = 5248.17 gr. (us FT)

**Notes:** The ground elevation at staked location = 5186.28' gr.  
 This drawing does not represent a monumented survey or Land Survey Plat.

**Basis of Bearing:** Bearings were determined based on the West line of Section 17 to bear S 00°51'00" E with all other bearings contained herein relative thereto.

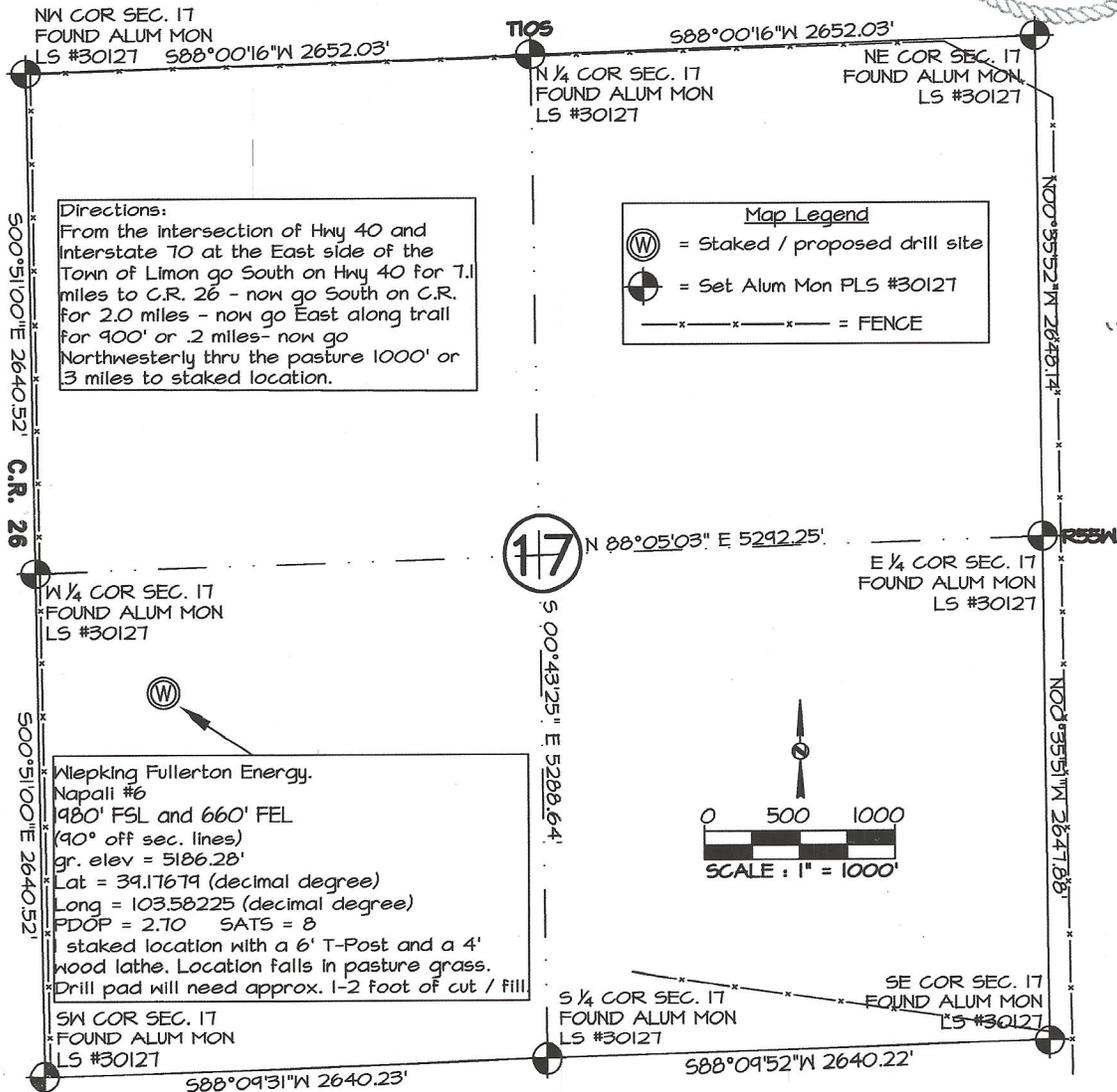

Wiepking Fullerton Energy.  
 Napali #6  
 1980' FSL and 660' FEL  
 (90° off sec. lines)  
 gr. elev = 5186.28'  
 Lat = 39.17679 (decimal degree)  
 Long = 103.58225 (decimal degree)  
 PDOP = 2.70 SATS = 8  
 staked location with a 6' T-Post and a 4' wood lathe. Location falls in pasture grass.  
 Drill pad will need approx. 1-2 foot of cut / fill