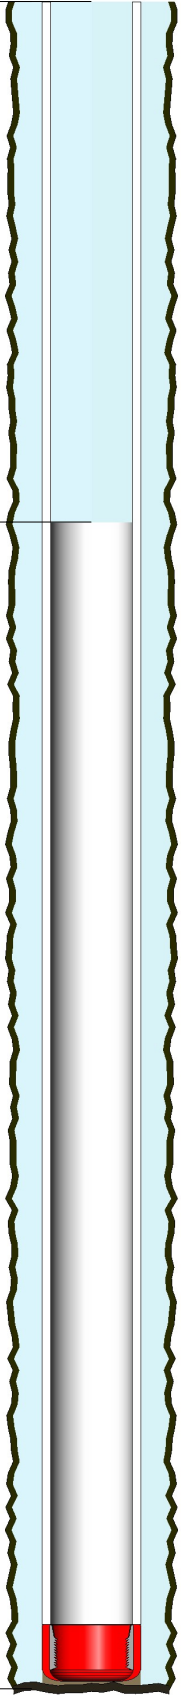


Casing Information	Casing Size & Weight	Cement Fluid (sacks)	Cement Depths (ft)	Schematic (2/9/2012)	Hole Size (in)	MD / PBMD (usft)	Perforation Intervals
SURFACE CASING - Set @ 950.1usft	8.625in, 24.00ppf	PRE FLUSH, WATER, TAIL, TYPE 3, 80	15 (TOC) 15 (TOC)				
		PRE FLUSH, WATER, LEAD, TYPE 3, 600 DISPLACEMENT, WATER,	315				