

Lat40°, Inc. 1635 Foxtrail Drive, Suite 325 Loveland, CO 970-776-3321

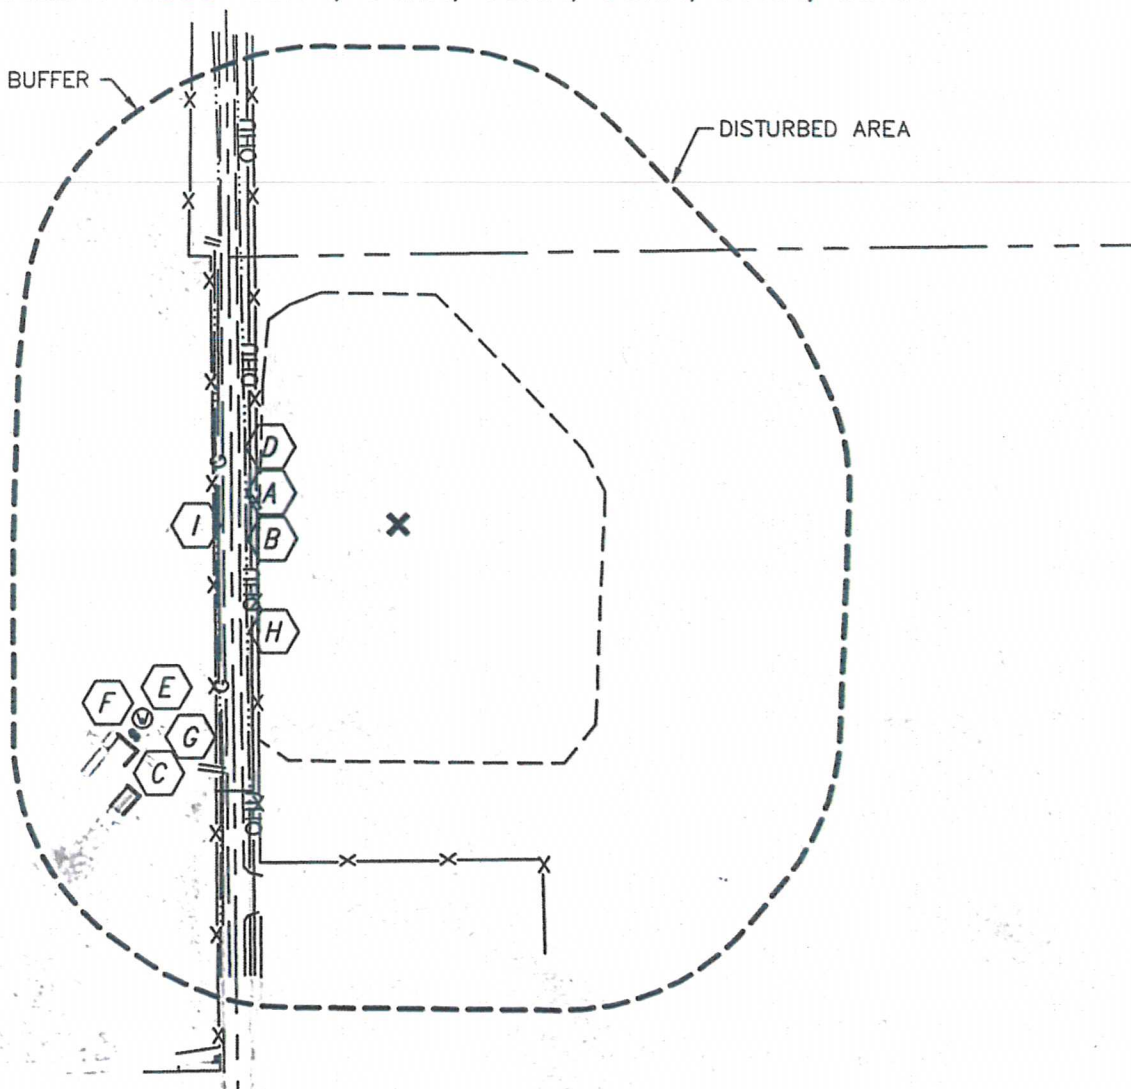
PRODUCTION FACILITY LOCATION DRAWING

WAHLERT AC33-65HN, 64HN, 63HN, 68HN, 67HN, 66HN

SECTION: 33
TOWNSHIP: 7N
RANGE: 63W

400' IMPROVEMENT BUFFER



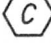

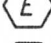
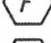



DISTURBED AREA




REFERENCE POINT LOCATION:

LATITUDE: 40.52904°N
LONGITUDE: 104.45024°W
ELEV: 4757'
PDOP: 1.2
DATE: 10/9/12
OPERATOR: ADAM KELLY
1/41/4: NW1/4SW1/4
FSL: 2199'
FWL: 273'
DISTANCE TO WELL: 841'
ASSOCIATED NEW WELLS:
WAHLERT AC33-65HN,
64HN, 63HN, 68HN,
67HN, 66HN
ASSOCIATED EXISTING WELLS:
NONE

IMPROVEMENTS:

-  COUNTY ROAD 65 259' W
-  OVERHEAD UTILITY 241' W
-  BUILDING 562' SW, 609' SW
-  FENCE 231' W, 302' W, 546' S
-  DOMESTIC WELL 523' SW
-  PROPANE TANK 548' SW
-  DRIVEWAY 540' NW, 490' SW, 610' SW
-  BARROW DITCH 249' W, 298' W
-  GAS LINE 294' W

LEGEND

 - REFERENCE POINT
ALL DISTANCES ARE APPROXIMATE.

NEAREST: BUILDING 562' SW,
PUBLIC ROAD 259' W, ABOVE GROUND UTILITY 241' W,
RAILROAD 5280'+, PROPERTY LINE 273' W

